

CO-OWNER INFORMATION BOOKLET

FOR

MORAVIAN MEADOWS

**A RESIDENTIAL CONDOMINIUM
LOCATED IN THE TOWNSHIP OF CLINTON
MACOMB COUNTY, MICHIGAN**

UPDATED: December, 2017

**MORAVIAN MEADOWS
TABLE OF CONTENTS**

**AMENDED AND RESTATED CONSOLIDATING MASTER DEED
MORAVIAN MEADOWS**

**AMENDED AND RESTATED CONDOMINIUM BYLAWS
MORAVIAN MEADOWS**

**CONDOMINIUM SUBDIVISION PLAN
MORAVIAN MEADOWS**

**RESTATED ARTICLES OF INCORPORATION
MORAVIAN MEADOWS ASSOCIATION**

**CERTIFICATE OF AMENDMENT TO THE
ARTICLES OF INCORPORATION
MORAVIAN MEADOWS ASSOCIATION**

**AMENDED AND RESTATED CONSOLIDATING MASTER DEED
OF MORAVIAN MEADOWS**

**AMENDED AND RESTATED CONSOLIDATING MASTER DEED OF
MORAVIAN MEADOWS
TABLE OF CONTENTS**

ARTICLE I	TITLE AND NATURE.....	2
Section 1.	Condominium Name, Subdivision Plan No. and No. of Units	2
Section 2.	Units and Co-owner Rights of Access to Common Elements	2
Section 3.	Voting.....	2
ARTICLE II	LEGAL DESCRIPTION.....	2
ARTICLE III	DEFINITIONS.....	3
Section 1.	General Description of Terms Used	3
Section 2.	Number and Gender of Words.....	4
ARTICLE IV	COMMON ELEMENTS.....	4
Section 1.	Common Elements.....	4
Section 2.	Responsibility for Unit and Common Elements	6
ARTICLE V	USE OF UNITS AND COMMON ELEMENTS	10
ARTICLE VI	UNIT DESCRIPTION AND PERCENTAGE OF VALUE.....	10
Section 1.	Unit Description	10
Section 2.	Calculation of Percentage of Value	10
ARTICLE VII	EASEMENTS.....	16
Section 1.	Easements for Encroachment, Utilities and Support	16
Section 2.	Association's Right to Grant Easements.....	16
Section 3.	Association's Easement for Maintenance, Repair and Replacement.....	16
Section 4.	Telecommunications Agreements.....	17
ARTICLE VIII	AMENDMENTS.....	17
Section 1.	Association Amendments.	17
Section 2.	Co-owner Approval	18
Section 3.	Mortgagee Consent.....	18
Section 4.	Modification of Units, Common Elements and Percentage of Value.....	18
Section 5.	Amendments for Secondary Mortgage Market Purposes	18

**AMENDED AND RESTATED CONSOLIDATING MASTER DEED OF
MORAVIAN MEADOWS
(ACT 59, PUBLIC ACTS OF 1978, AS AMENDED)
MACOMB COUNTY CONDOMINIUM SUBDIVISION PLAN NO. 208**

This Amended and Restated Consolidating Master Deed of Moravian Meadows is made and executed this 1st day of December, 2017, by Moravian Meadows Association, a Michigan nonprofit corporation (the "Association"), in accordance with the Michigan Condominium Act (being Act 59 of the Public Acts of 1978, as amended) (the "Condominium Act").

The Association desires by recording this Amended and Restated Consolidating Master Deed to reaffirm the establishment of the real property described in Article II of this Amended and Restated Consolidating Master Deed, together with all the improvements now located upon or appurtenant to such real property, as a residential condominium project under the Condominium Act. The Consolidating Master Deed for Moravian Meadows, recorded in Liber 6100, Pages 662 et seq., along with the Amendment recorded in Liber 6393, Pages 213, et seq., and the Amendment recorded in Liber 21148, Pages 710 et seq., Macomb County Records, are superseded by this Amended and Restated Consolidating Master Deed of Moravian Meadows (except for the Condominium Subdivision Plan (defined below) attached to the Consolidating Master Deed as Exhibit B and as subsequently amended).

The Association does, upon the recording of this Amended and Restated Consolidating Master Deed, reaffirm the establishment of Moravian Meadows as a Condominium under the Condominium Act and does declare that Moravian Meadows (the "Condominium") shall, after such establishment, be held, conveyed, hypothecated, encumbered, leased, rented, occupied, improved, or in any other manner utilized, subject to the Condominium Act, and to the covenants, conditions, restrictions, uses, limitations, and affirmative obligations set forth in this Amended and Restated Consolidating Master Deed and Exhibits A and B applicable to this Amended and Restated Consolidating Master Deed, all of which run with the real property described in Article II of this Amended and Restated Consolidating Master Deed and are a burden and a benefit to the Association, its successors and assigns, and any persons acquiring or owning an interest in such real property, their grantees, successors, heirs, executors, administrators and assigns. In furtherance of the establishment of the Condominium, it is provided as follows:

568

C

**ARTICLE I
TITLE AND NATURE**

Section 1. Condominium Name, Subdivision Plan No. and No. of Units. The Condominium shall be known as Moravian Meadows, Macomb County Condominium Subdivision Plan No. 208. The Condominium is established in accordance with the Condominium Act. The Condominium consists of 240 Units, numbered 1 through 42, inclusive, 44 through 46, inclusive, 48 through 163, inclusive, 165, 166, 168 through 190, inclusive, 192, 193, 195 through 202, inclusive, 204 through 226, inclusive, and 228 through 248, inclusive.

Section 2. Units and Co-owner Rights of Access to Common Elements. The Units contained in the Condominium, including the number, boundaries and dimensions of each Unit, are set forth in the Condominium Subdivision Plan. Each Unit is capable of individual utilization on account of having its own access to a Common Element. Each Co-owner shall have an exclusive right to their Unit and shall have undivided and inseparable rights to share with the other Co-owners the Common Elements as are designated by this Amended and Restated Consolidating Master Deed.

Section 3. Voting. Co-owners shall have voting rights in Moravian Meadows Association as set forth in this Amended and Restated Consolidating Master Deed, in the Amended and Restated Bylaws, and in the Association's Articles of Incorporation.

**ARTICLE II
LEGAL DESCRIPTION**

The land that comprises the Condominium covered by this Amended and Restated Consolidating Master Deed, which is located in the Township of Clinton, Macomb County, Michigan, is particularly described as follows:

Part of Lots 2 through 8, both inclusive, "Moravian Drive Farms" a subdivision of part of fractional Sections 16 and 21 and part of Private Claim 137, Town 2 North, Range 13 East, Clinton Township, Macomb County, Michigan, as recorded in Liber 23, Page 10 and being more particularly described as follows: Beginning at the intersection of the meander line along Harrington Creek and the Westerly line of Lot 2 and Easterly line of Mt. Lebanon Subdivision as recorded in Liber 37, Pages 27 and 28; thence North 41°28'40" West 1046.66 feet along said line; thence North 44°39' East 333.61 feet; thence North 52°35' West 159.27 feet; thence South 44°39' West 147.09 feet; thence North 55°23'36" West 144.21 feet to a point in the southerly right-of-way of Moravian Drive (120.00 feet wide); thence North 44°39' East 174.38 feet along the southerly right-of-way of said Moravian Drive; thence South 52°35' East 302.41 feet; thence North 44°39' East 160.62 feet to a point on the line common to Lots 3 and 4 of said "Moravian Drive Farms"; thence North 32°13' East 178.12 feet; thence North 52°35' West 313.64 feet to a point on the southerly right-of-way line of said Moravian Drive (120.00 feet wide); thence North 32°13' East 100.00 feet along the right-of-way of Moravian Drive (120.00 feet wide); thence South 52°35' East 313.64 feet; thence North 32°13' East 331.33 feet to a point on the line common to Lots 6 and 7 of said (Moravian Drive Farms); thence North 52°35' West 13.64 feet along the said line common to Lots 6 and 7; thence North 32°13 East 411.22 feet to a point on the line common to Lots 8 and 9 of said (Moravian Drive Farms); thence South 52°35' East 628.28 feet along the said line common to Lots 8 and 9 to a point on meander line of said

Harrington Creek, thence along said meander line of the Harrington Creek the following courses and distances; South 00°57' West 148.40 feet South 13°47' West 216.95 feet, South 01°25' East 384.75 feet, South 66°25' East 458.50 feet, South 45°09' West 552.70 feet, South 22°25' West 187.10 feet, recorded, South 76°13' West 631.80 feet measured South 76°13'30" West 631.11 feet to the point of beginning and containing 43.657 acres to meander line. Boundary lines extended to the centerline of Harrington Creek, subject to all easements and restrictions of record and all governmental limitations.

ARTICLE III DEFINITIONS

Section 1. General Description of Terms Used. Certain terms are utilized not only in this Amended and Restated Consolidating Master Deed and Exhibits A and B, but are or may be used in various other instruments such as, by way of example and not limitation, the Articles of Incorporation and rules and regulations of Moravian Meadows Association, and deeds, mortgages, liens, land contracts, easements and other instruments affecting the establishment or transfer of interests in Moravian Meadows. Wherever used in such documents or any other pertinent instruments, the terms set forth below are defined as follows:

A. The "Act" or "Condominium Act" means the Michigan Condominium Act, being Act 59 of the Public Acts of 1978, as amended. If any provision of this Amended and Restated Consolidating Master Deed or its exhibits conflicts with any provision of the Condominium Act, or if any provision required by the Condominium Act is omitted, then the Condominium Act provisions are incorporated by reference and shall supersede and cancel any conflicting provision.

B. "Amended and Restated Bylaws" or "Bylaws" means Exhibit A attached to this Amended and Restated Consolidating Master Deed, being the Bylaws setting forth the substantive rights and obligations of the Co-owners. The Amended and Restated Bylaws also constitute the Association's corporate bylaws under the Michigan Nonprofit Corporation Act.

C. "Amended and Restated Consolidating Master Deed" means this document, and to which the Amended and Restated Bylaws are attached as Exhibit A, and the Condominium Subdivision Plan is made applicable as Exhibit B.

D. "Association" means Moravian Meadows Association, a nonprofit corporation organized under Michigan law of which all Co-owners are members. The Association shall administer, operate, manage and maintain the Condominium in accordance with all applicable laws and the Condominium Documents (defined below). Any action required of or permitted to the Association is exercisable by its Board of Directors unless specifically reserved to the Co-owners by the Condominium Documents or Michigan law.

E. "Common Elements" where used without modification means both the General and Limited Common Elements described in Article IV of this Amended and Restated Consolidating Master Deed, and does not refer to Units.

F. "Condominium Documents" means and includes this Amended and Restated Consolidating Master Deed, the Amended and Restated Bylaws, the Condominium Subdivision Plan, the Association's Articles of Incorporation, and the rules and regulations of the Association.

G. "Condominium" means Moravian Meadows as a Condominium established in conformity with the Condominium Act.

H. "Condominium Subdivision Plan" means the Condominium Subdivision Plan attached to the Consolidating Master Deed as Exhibit B and as subsequently amended, which is incorporated and made applicable by reference.

I. "Co-owner" means a person, firm, corporation, limited liability company, partnership, association, trust or other legal entity or any combination of the foregoing who or which owns one or more Units. Both land contract vendees and vendors are considered Co-owners and are jointly and severally liable for all obligations and responsibilities of Co-owners under the Condominium Documents and the Condominium Act.

J. "Developer" refers to Karam Brothers, Inc., a Michigan corporation, which made and executed the Consolidating Master Deed.

K. "Percentage of Value" means the percentage assigned to each Unit in Article VI of this Amended and Restated Consolidating Master Deed. The percentages of value of all Units total one hundred percent (100%). Percentages of value are determinative only with respect to those matters to which they are specifically deemed to relate either in the Condominium Documents or in the Condominium Act.

L. "Person" means an individual, firm, corporation, limited liability company, partnership, association, trust, or other legal entity, or any combination of the foregoing.

M. "Record" means to record pursuant to the laws of the State of Michigan relating to the recording of deeds.

N. "Unit" means a single Unit in Moravian Meadows, as such is described in Article VI of this Amended and Restated Consolidating Master Deed and on the Condominium Subdivision Plan, and shall have the same meaning as the term "Condominium Unit" as defined in the Condominium Act.

Section 2. Number and Gender of Words. Whenever any reference is made to one gender, the same shall include a reference to all genders where the same would be appropriate. Similarly, whenever a reference is made to the singular, a reference shall also be included to the plural where the same would be appropriate.

ARTICLE IV COMMON ELEMENTS

Section 1. Common Elements. The Common Elements are described in the Condominium Subdivision Plan and as follows:

A. General Common Elements. The General Common Elements are:

- (1) Land. The land described in Article II of this Amended and Restated Consolidating Master Deed, including the private roads;
- (2) Electrical. The electrical transmission system throughout the Condominium, including that contained within Unit walls, up to the point of connection with, but not including, electrical fixtures, plugs and switches within any Unit;
- (3) Telephone. The telephone system throughout the Condominium up to the point of entry to each Unit;
- (4) Gas. The gas distribution system throughout the Condominium, including that contained within Unit walls, up to the point of connection with gas fixtures within any Unit;
- (5) Water. The water distribution system throughout the Condominium, including that contained within Unit walls, up to the point of connection with plumbing fixtures within any Unit;
- (6) Sanitary Sewer. The sanitary sewer system throughout the Condominium, including ejector pumps and including those portions of the sanitary sewer system contained within Unit walls, from the point of connection with plumbing fixtures within any Unit;
- (7) Storm Sewer. The storm sewer system throughout the Condominium, including sump pumps and related accessories throughout the Condominium;
- (8) Telecommunications. The telecommunications system throughout the Condominium up to, but not including, connections to provide service to individual Units;
- (9) Construction. Foundations, supporting columns, Unit perimeter walls, roofs, ceilings, floor construction and chimneys;
- (10) Irrigation System. The irrigation system throughout the Condominium, including all lines, valves, timers, heads and related equipment;
- (11) Entryway Signage and Gatehouse. The entryway signage, gatehouse and related improvements and landscaping;
- (12) Street Lighting System. The common street lighting system serving the Condominium, including related wiring and fixtures; and
- (13) Other. All other elements and improvements contained within or appurtenant to the Condominium, which are not designated as General or Limited Common Elements, which are not enclosed within the boundaries of a Unit and which are intended for common use or are necessary to the existence, upkeep and safety of the Condominium.

Some or all of the utility lines, systems (including mains and service leads) and equipment described above ("utility systems") may be owned by the local public authority or by the company that

is providing the pertinent service. Accordingly, such utility systems are General Common Elements only to the extent of the Co-owners' interest in such utility systems, if any.

Some or all of the utility systems service single buildings containing more than one Unit. Accordingly, and where necessary or applicable, there shall be an easement for that Common Element through each Unit to enable the utility systems to appropriately serve each of the Units in the subject building.

B. Limited Common Elements. Limited Common Elements are subject to the exclusive use and enjoyment of the Co-owner of the Unit to which the Limited Common Elements serve. The Limited Common Elements follow:

(1) Patio and Deck Areas. Each individual open patio area, enclosed patio area or deck area, as applicable, is limited in use to the Co-owner of the Unit to which such area is appurtenant;

(2) Porches. Each individual porch in the Condominium is limited in use to the Co-owner of the Unit which opens into such porch as shown on the Condominium Subdivision Plan;

(3) Garages and Driveways. Certain garages, garage floors and adjacent driveway spaces are limited in use to the Co-owner of the Unit to which these items are appurtenant as designated on the floor plans of the Condominium Subdivision Plan.

(4) Garage Doors, Hardware and Openers. The garage door, garage door hardware and electric garage door opener is limited in use to the Co-owner of the Unit to which these items are appurtenant;

(5) Air-Conditioner. Each air-conditioning compressor, compressor pad, and the land underneath the pad is limited in use to the Co-owner of the Unit to which such air-conditioning compressor, pad and land are appurtenant;

(6) Attic Storage Area. Each individual attic storage area in the Condominium is limited in use to the Co-owner of the Unit to which such storage space is appurtenant;

(7) Doors, Door-walls, Windows and Screens. Doors, door-walls, windows and screens are limited in use to the Co-owner of the Unit to which these items are appurtenant; and

(8) Interior Surfaces. The interior surfaces of Unit and garage perimeter walls, ceilings and floors contained within a Unit are limited in use to the Co-owner of the Unit to which such interior surfaces are appurtenant.

Section 2. Responsibility for Unit and Common Elements. Subject to the Association's exclusive right and obligation to control and approve the exterior appearance and use of all Units and Common Elements as set out in this Amended and Restated Consolidating Master Deed and in the relevant sections of Article VI of the Amended and Restated Bylaws, the respective responsibilities for the maintenance, decoration, repair and replacement of the Units and Common Elements are as follows:

A. Co-owner Responsibilities:

(1) Unit and Certain Common Elements. Except as provided in Section 2B below and subject to the Amended and Restated Bylaws, the primary responsibility for maintenance, decoration, repair and replacement, including all associated costs, of a Unit, including all fixtures, improvements and personal property located within the Unit or elsewhere throughout the Condominium, the Limited Common Elements, and those General Common Elements described in this Section 2A(1), shall be borne by the Co-owner of the Unit. The following provisions add to and clarify, but do not limit, each Co-owner's decoration, maintenance, repair and replacement responsibilities under this Section 2A(1):

(a) Electrical lines, wires, outlets, switches, boxes, circuit breakers, panels, and interior and exterior fixtures serving the individual Unit from the point of connection with, and including, the electrical meter for the Unit;

(b) Gas lines, pipes, valves and fixtures from the point of connection with, and including, the gas meter for the Unit;

(c) Water lines, pipes, valves and fixtures from and including the Unit's first shut off valve located within and serving only the Unit, but not including exterior water spigots, any water meters, or any mains or lines running through the Unit to serve other Units or the General Common Elements;

(d) All drain lines and traps within a Unit;

(e) Air-conditioner compressor, its pad and other related equipment and accessories;

(f) Windows, interior doors, door-walls, Unit entry doors, including their storms, screens, frames, locks, hardware, thresholds, sills and weather stripping; provided, that, even though Co-owners have the primary responsibility for painting Unit entry doors, the Association is permitted to periodically paint the exterior of Unit entry doors in accordance with the Association's maintenance schedule;

(g) Garage floor slab, garage door including tracks, springs, opener, remote, and all related hardware and equipment; provided, that, even though Co-owners have the primary responsibility for painting garage doors, the Association is permitted to periodically paint the exterior of garage doors in accordance with the Association's maintenance schedule;

(h) All Unit interior wall construction;

(i) Drywall repair, replacement, maintenance and painting;

(j) Deck and all improvements located on or related to the deck including railings, decking, joists and posts;

(k) Porch and related steps and rails, if any;

(l) Unenclosed patios, including any related rails, stairs or gates; provided, that the Association shall be responsible for any related patio perimeter walls as more fully set forth in Section 2B(1) below;

(m) Enclosed patios, including any related perimeter wall, floor and ceiling construction; provided, however, that the Association shall be responsible for the enclosed patio roofs;

(n) Any and all landscaping, including trees and flowers, located within any landscape bed located adjacent to the side elevation of a Co-owner's end Unit;

(o) Improvements and decorations to the Unit including, without limitation, interior walls, tile, either floor or wall, paint, wallpaper, window treatments, carpeting or other floor covering, trim, cabinets, counters, sinks and related hardware;

(p) Appliances and equipment within the Unit and supporting hardware and equipment including, but not limited to, furnace and related ductwork, humidifier, air cleaner, any personal alarm system, garbage disposal, dishwasher, microwave, range, oven, refrigerator, vent fans and related ductwork, dryer venting, vent covers and filters, individual hot water heaters, backup sump pumps (but not including the primary sump pump, which is an Association responsibility), fireplaces, flues and dampers;

(q) All other items not specifically enumerated above, but which are located within the boundaries of a Unit.

(2) Co-owner Additions, Modifications. Co-owner improvements, additions or modifications, even though approved by the Board of Directors, are not considered Common Elements in any case and, except as the Board determines otherwise in writing, are the complete responsibility of the Co-owner. Should the Association require access to any Common Elements which necessitates the moving or destruction of all or part of any such addition or modification, all costs, damages and expenses involved in providing access and restoring the addition or modification shall be assessed to and collected from the responsible Co-owner in the manner provided in Article II of the Amended and Restated Bylaws. Co-owners shall not alter, replace, remove, paint, decorate or change the exterior of a Unit or any exterior appendage including, without limitation, decks, patios, porches, air conditioning units, windows and Unit entry doors, whether exclusively used by the Co-owner or otherwise, without first obtaining the Board's prior written consent pursuant to Article VI of the Amended and Restated Bylaws.

(3) Sump Pumps and Irrigation Equipment. A Co-owner whose Unit contains common sump pump or common irrigation equipment shall not restrict the Association or its contractors or utility companies from entering into the Unit to maintain, repair or replace such equipment. To ensure there is reasonable accessibility to such equipment, Co-owners shall not convert the portion of the Unit containing such equipment to living area without prior written approval of the Board of Directors. The Association shall not be responsible for damage to floor tile, carpeting, paneling, wall coverings, walls or other improvements or property in the Unit or Limited Common Elements if such items are blocking access to the equipment.

(4) Co-owner Fault. Subject to the provisions of Article VI, Section 14 of the Amended and Restated Bylaws, all costs for maintenance, decoration, repair and replacement of any

Common Element caused by the intentional or unintentional act of any Co-owner, or family, guests, tenants or invitees of a Co-owner, shall be borne by the Co-owner. The Association may incur such costs and charge and collect them from the responsible Co-owner in the same manner as an assessment in accordance with Article II of the Amended and Restated Bylaws.

(5) Repair to Association Specifications. All maintenance, repair and replacement obligations of the Co-owners as described above and as provided in the Amended and Restated Bylaws shall be performed subject to the Association's mandatory prior written approval and control with respect to color, style, timing, material and appearance. Further, all maintenance, repair and replacement shall be performed in compliance with all applicable municipal, State and federal codes and regulations.

B. Association Responsibilities:

(1) Limited Common Elements. Except in cases of Co-owner fault, the Association shall be responsible for the maintenance, repair and replacement of the following:

(a) Enclosed patio area roofs, consisting of decking, flashing, underlayment, roof venting and shingles, and the expenses incurred shall be an expense of administration;

(b) Unenclosed patio perimeter walls, and the expenses incurred shall be an expense of administration; and

(c) Skylights, and the expenses shall be borne by the Co-owner of the Unit to which the skylight is associated.

(2) General Common Elements. The costs of maintenance, decoration, repair and replacement of all General Common Elements (except those assigned to the Co-owners under the various subsections of Section 2A above), shall be an expense of administration, subject to the provisions of this Article and the Amended and Restated Condominium Bylaws.

(3) Unauthorized Repair. The Association shall not be obligated to reimburse any Co-owner for repairs made or contracted for by the Co-owner. Unless otherwise determined by the Board of Directors, the Association shall only be responsible for payments to contractors for work authorized by the Board of Directors or by a management company hired by the Association.

C. Utility Charges. All individually metered utility services shall be borne by the Co-owner of the Unit to which such services are furnished. All commonly metered utilities shall be paid by the Association as an expense of administration.

D. Unusual Expenses. Any other unusual common expenses benefiting less than all Units, or any expenses incurred as a result of the conduct of less than all of those entitled to occupy the Condominium, or by their licensees or invitees, shall be specifically assessed against the Unit or Units involved in accordance with Section 69 of the Condominium Act.

**ARTICLE V
USE OF UNITS AND COMMON ELEMENTS**

No Co-owner shall use their Unit or the Common Elements in any manner inconsistent with the purposes of the Condominium, the Condominium Documents, zoning and other ordinances and codes of the Township of Clinton, State and Federal laws and regulations, or in any manner which will interfere with or impair the rights of any other Co-owner in the use and enjoyment of their Unit or the Common Elements.

**ARTICLE VI
UNIT DESCRIPTION AND PERCENTAGE OF VALUE**

Section 1. Unit Description. Each Unit is described in this Section with reference to the Condominium Subdivision Plan of Moravian Meadows as prepared by Robert Shanayda. Each Unit shall include: (1) with respect to each Unit having a basement, all that space contained within the unpainted surfaces of the basement floor and walls and the uncovered underside of the first-floor joists; and (2) with respect to the Unit upper floors, all that space contained within the finished unpainted walls and ceilings and from the finished subfloor, all as shown on the floor plans and sections in the Condominium Subdivision Plan and delineated with heavy outlines. Building elevations are shown in detail in architectural plans and specifications on file with the Township of Clinton.

Section 2. Calculation of Percentage of Value. The percentage of value assigned to each Unit shall be determinative of the undivided interests of the Co-owner in the Common Elements; however, the value of each Co-owner's vote at meetings of the Association and the proportionate share of each Co-owner in the proceeds and expenses of the administration (except to the extent modified by the assignment of responsibility for expenses contained in Article IV of this Amended and Restated Consolidating Master Deed) shall be equal. The total percentage value of the Condominium is one hundred percent (100%). The percentages of value were computed on the basis of the relative, approximate areas of the Units, disregarding insubstantial differences in size, but giving consideration for basements. The Units and their associated percentages of value are as follows:

<u>Unit Number</u>	<u>Type of Unit</u>	<u>Percentage of Value Assigned</u>
1	2-bedroom	.395
2	2-bedroom	.395
3	2-bedroom	.395
4	2-bedroom	.395
5	2-bedroom	.395
6	2-bedroom	.395
7	2-bedroom	.395
8	2-bedroom	.395
9	2-bedroom	.395
10	2-bedroom	.395
11	2-bedroom	.395
12	2-bedroom	.395
13	2-bedroom	.395

14	2-bedroom	.395
15	2-bedroom	.395
16	2-bedroom	.395
17	2-bedroom	.395
18	2-bedroom	.395
19	2-bedroom	.483
20	2-bedroom	.395
21	2-bedroom	.395
22	2-bedroom	.395
23	2-bedroom	.395
24	2-bedroom	.395
25	2-bedroom	.395
26	2-bedroom	.395
27	2-bedroom	.395
28	2-bedroom	.395
29	2-bedroom	.395
30	2-bedroom	.395
31	2-bedroom	.395
32	2-bedroom	.395
33	2-bedroom	.395
34	2-bedroom	.395
35	2-bedroom	.395
36	2-bedroom	.395
37	2-bedroom	.395
38	2-bedroom	.395
39	2-bedroom	.395
40	2-bedroom	.395
41	2-bedroom	.572
42	2-bedroom	.483
43	intentionally omitted	
44	2-bedroom	.572
45	2-bedroom	.483
46	2-bedroom	.395
47	intentionally omitted	
48	2-bedroom	.572
49	2-bedroom	.483
50	2-bedroom	.395
51	2-bedroom	.395
52	2-bedroom	.483
53	2-bedroom	.395
54	2-bedroom	.395
55	2-bedroom	.395
56	2-bedroom	.395
57	2-bedroom	.395
58	2-bedroom	.395
59	2-bedroom	.395

60	2-bedroom	.395
61	2-bedroom	.395
62	2-bedroom	.395
63	2-bedroom	.395
64	2-bedroom	.483
65	2-bedroom	.572
66	2-bedroom	.395
67	2-bedroom	.395
68	2-bedroom	.395
69	2-bedroom	.483
70	2-bedroom	.395
71	2-bedroom	.395
72	2-bedroom	.395
73	2-bedroom	.483
74	2-bedroom	.395
75	2-bedroom	.395
76	2-bedroom	.483
77	2-bedroom	.395
78	2-bedroom	.395
79	2-bedroom	.395
80	2-bedroom	.395
81	2-bedroom	.395
82	2-bedroom	.395
83	2-bedroom	.395
84	2-bedroom	.395
85	2-bedroom	.395
86	2-bedroom	.483
87	2-bedroom	.395
88	2-bedroom	.395
89	2-bedroom	.395
90	2-bedroom	.395
91	2-bedroom	.395
92	2-bedroom	.395
93	2-bedroom	.395
94	2-bedroom	.395
95	2-bedroom	.395
96	2-bedroom	.395
97	2-bedroom	.395
98	2-bedroom	.395
99	2-bedroom	.395
100	2-bedroom	.395
101	2-bedroom	.395
102	2-bedroom	.395
103	2-bedroom	.395
104	2-bedroom	.395
105	2-bedroom	.395

106	2-bedroom	.395
107	2-bedroom	.395
108	2-bedroom	.395
109	2-bedroom	.395
110	2-bedroom	.395
111	2-bedroom	.395
112	2-bedroom	.483
113	2-bedroom	.395
114	2-bedroom	.395
115	2-bedroom	.395
116	2-bedroom	.395
117	2-bedroom	.395
118	2-bedroom	.395
119	2-bedroom	.395
120	2-bedroom	.395
121	2-bedroom	.395
122	2-bedroom	.395
123	2-bedroom	.395
124	2-bedroom	.483
125	2-bedroom	.483
126	2-bedroom	.395
127	2-bedroom	.395
128	2-bedroom	.395
129	2-bedroom	.395
130	2-bedroom	.395
131	2-bedroom	.395
132	2-bedroom	.395
133	2-bedroom	.395
134	2-bedroom	.483
135	2-bedroom	.395
136	2-bedroom	.395
137	2-bedroom	.395
138	2-bedroom	.395
139	2-bedroom	.395
140	2-bedroom	.395
141	2-bedroom	.395
142	2-bedroom	.395
143	2-bedroom	.395
144	2-bedroom	.395
145	2-bedroom	.395
146	2-bedroom	.395
147	2-bedroom	.395
148	2-bedroom	.395
149	2-bedroom	.483
150	2-bedroom	.395
151	2-bedroom	.395

152	2-bedroom	.395
153	2-bedroom	.395
154	2-bedroom	.395
155	2-bedroom	.395
156	2-bedroom	.483
157	2-bedroom	.395
158	2-bedroom	.395
159	2-bedroom	.395
160	2-bedroom	.483
161	2-bedroom	.572
162	2-bedroom	.395
163	2-bedroom	.660
164	intentionally omitted	
165	2-bedroom	.483
166	2-bedroom	.483
167	intentionally omitted	
168	2-bedroom	.483
169	2-bedroom	.395
170	2-bedroom	.395
171	2-bedroom	.395
172	2-bedroom	.395
173	2-bedroom	.483
174	2-bedroom	.395
175	2-bedroom	.395
176	2-bedroom	.483
177	2-bedroom	.395
178	2-bedroom	.395
179	2-bedroom	.395
180	2-bedroom	.483
181	2-bedroom	.395
182	2-bedroom	.395
183	2-bedroom	.483
184	2-bedroom	.395
185	2-bedroom	.395
186	2-bedroom	.395
187	2-bedroom	.395
188	2-bedroom	.395
189	2-bedroom	.483
190	2-bedroom	.483
191	intentionally omitted	
192	2-bedroom	.483
193	2-bedroom	.572
194	intentionally omitted	
195	2-bedroom	.395
196	2-bedroom	.660
197	2-bedroom	.395

198	2-bedroom	.395
199	2-bedroom	.395
200	2-bedroom	.395
201	2-bedroom	.483
202	2-bedroom	.483
203	intentionally omitted	
204	2-bedroom	.483
205	2-bedroom	.395
206	2-bedroom	.483
207	2-bedroom	.395
208	2-bedroom	.395
209	2-bedroom	.395
210	2-bedroom	.395
211	2-bedroom	.395
212	2-bedroom	.395
213	2-bedroom	.395
214	2-bedroom	.483
215	2-bedroom	.395
216	2-bedroom	.395
217	2-bedroom	.395
218	2-bedroom	.395
219	2-bedroom	.395
220	2-bedroom	.395
221	2-bedroom	.395
222	2-bedroom	.395
223	2-bedroom	.395
224	2-bedroom	.483
225	2-bedroom	.483
226	2-bedroom	.483
227	intentionally omitted	
228	2-bedroom	.483
229	2-bedroom	.395
230	2-bedroom	.395
231	2-bedroom	.395
232	2-bedroom	.483
233	2-bedroom	.483
234	2-bedroom	.395
235	2-bedroom	.395
236	2-bedroom	.483
237	2-bedroom	.395
238	2-bedroom	.395
239	2-bedroom	.395
240	2-bedroom	.395
241	2-bedroom	.483
242	2-bedroom	.395
243	2-bedroom	.395

244	2-bedroom	.395
245	2-bedroom	.483
246	2-bedroom	.395
247	2-bedroom	.395
248	2-bedroom	<u>.395</u>
	Total	100.000

**ARTICLE VII
EASEMENTS**

Section 1. Easements for Encroachment, Utilities and Support.

A. In the event any Unit or Common Element encroaches upon another Unit or Common Element, whether by deviation from the plans in the construction, repair, renovation, restoration, or replacement of any improvement, or by reason of the settling or shifting of any land or improvement, a valid easement for the encroachment shall exist, except to the extent limited by Section 40 of the Condominium Act.

B. There are easements to, through and over those portions of the land, structures, buildings, improvements and walls contained therein for the installation, maintenance and servicing of all utilities in the Condominium, including, but not limited to, lighting, heating, power, sewer, water and communications including telephone, cable television and internet lines.

C. Easements of support shall exist with respect to any Unit wall that supports a Common Element.

Section 2. Association's Right to Grant Easements. The Board of Directors may grant easements and licenses over or through any portion of any General Common Elements for utility, roadway, construction, safety purposes, or for any other purpose as may be beneficial to the Condominium.

Section 3. Association's Easement for Maintenance, Repair and Replacement. The Association and all public or private utilities shall have such easements over, under, across and through the Condominium, including all Units and Common Elements, as may be necessary to fulfill any responsibilities of maintenance, repair, decoration, replacement or upkeep which they or any of them are required or permitted to perform under the Condominium Documents or by law, or to respond to any emergency or common need of the Condominium. It is a matter of concern that a Co-owner may fail to properly maintain their Unit or any Common Elements for which the Co-owner is responsible in a proper manner and in accordance with the standards set forth in the Condominium Documents. Therefore, in the event a Co-owner fails to properly and adequately maintain, decorate, repair, replace or otherwise keep in good condition and repair their Unit or any improvements or appurtenances located within the Unit or any Common Elements for which the Co-owner is responsible, the Association shall have the right (but not the obligation) and all necessary easements to take whatever actions it deems desirable to so maintain, decorate, repair or replace the Unit, its appurtenances or any of the Common Elements for which the Co-owner is responsible, all at the expense of the Co-owner of the Unit. The Association shall not be liable to the Co-owner of any Unit or any other person in trespass or in any other form of action for the exercise of rights pursuant to the provisions of this Section or any other provision of the

Condominium Documents that grant such easements, rights of entry or other means of access. Failure of the Association to take any such action shall not be deemed a waiver of the Association's right to take any such action at a future time. All costs incurred by the Association in performing any Co-owner-responsibilities as set forth in this Section shall be assessed against such Co-owner in accordance with Article II of the Amended and Restated Bylaws and shall be immediately due and payable. Further, the lien for nonpayment shall attach as in all cases of regular assessments, and such assessments may be enforced using all means available to the Association under the Condominium Documents and by law for the collection of regular assessments including, without limitation, legal action, foreclosure of the lien securing payment and imposition of fines.

Section 4. Telecommunications Agreements. The Association, acting through its duly constituted Board of Directors, shall have the power to make or cause to be made such installations and/or grant such easements, licenses and other rights of entry, use and access and to enter into any contract or agreement, including wiring agreements, right-of-way agreements, access agreements and multi-Unit agreements and, to the extent allowed by law, contracts for sharing of any installation or periodic subscriber service fees as may be necessary, convenient or desirable to provide for telecommunications, videotext, broadband cable, satellite dish, earth antenna and similar services (collectively, "Telecommunications") to the Condominium or any Unit. Notwithstanding the foregoing, in no event shall the Board of Directors enter into any contract or agreement or grant any easement, license or right of entry or do any other act or thing which will violate any provision of any federal, state or local law or ordinance. Any and all sums paid by any Telecommunications or other company or entity in connection with such service, including fees, if any, for the privilege of installing the same or sharing periodic subscriber service fees, are receipts of administration of the Condominium within the meaning of the Condominium Act and shall be paid over to and shall be the property of the Association.

ARTICLE VIII AMENDMENTS

This Amended and Restated Consolidating Master Deed, the Amended and Restated Bylaws and the Condominium Subdivision Plan may be amended as provided in the Condominium Act and in the following manner, and shall be effective upon recordation with the Macomb County Register of Deeds:

Section 1. Association Amendments. The Association acting through its Board of Directors may make and record amendments to this Amended and Restated Consolidating Master Deed, the Amended and Restated Bylaws or the Condominium Subdivision Plan without the consent of Co-owners or mortgagees if the amendment does not materially alter or change the rights of a Co-owner or mortgagee.

Section 2. Co-owner Approval. Except as otherwise provided in this Amended and Restated Consolidating Master Deed and subject to Sections 3 and 4 below, the Association may make and record amendments to this Amended and Restated Consolidating Master Deed, the Amended and Restated Bylaws or the Condominium Subdivision Plan upon the affirmative vote of two-thirds (2/3^{rds}) of the Co-owners in good standing as of the date for such vote, which shall be the date that the acceptance of votes ends unless otherwise established by the Board of Directors.

Section 3. Mortgagee Consent. Whenever a proposed amendment would materially alter or change the rights of mortgagees (as defined in Section 90a(9) of the Condominium Act), such

amendment shall require the consent of not less than two-thirds (2/3rds) of all first mortgagees of record. A mortgagee shall have one vote for each mortgage held. Mortgagee approval shall be solicited in accordance with Section 90a of the Condominium Act.

Section 4. Modification of Units, Common Elements and Percentage of Value. Notwithstanding any other provision of this Article, the method or formula used to determine the percentages of value of Units, as described in Article VI of this Amended and Restated Consolidating Master Deed, may not be modified without the consent of each affected Co-owner and mortgagee, except as permitted by the Condominium Act, as amended. A Co-owner's Unit dimensions or appurtenant Limited Common Elements may not be modified without the Co-owner's consent. The Condominium may be terminated only in accordance with Section 51 of the Condominium Act. Common Elements can be assigned and reassigned only in accordance with Section 39 of the Condominium Act. Units may be consolidated and boundaries relocated as provided in Sections 47 and 48 of the Condominium Act.

Section 5. Amendments for Secondary Mortgage Market Purposes. The Association may amend this Amended and Restated Consolidating Master Deed or the Amended and Restated Bylaws to facilitate mortgage loan financing for existing or prospective Co-owners and to enable the purchase or insurance of such mortgage loans by the Federal Home Loan Mortgage Corporation, the Federal National Mortgage Association, the Government National Mortgage Association, the Veterans Administration, the Department of Housing and Urban Development, Michigan State Housing Development Authority or by any other institutional participant in the secondary mortgage market which purchases or insures mortgages. The foregoing amendments may be made without the consent of Co-owners or mortgagees.

[Signature Appears on Following Page]

The Association has caused this Amended and Restated Consolidating Master Deed to be executed the day and year first above written

Moravian Meadows Association, a Michigan Nonprofit Corporation

By: Sam Sage
Name: Sam Sage
Title: President

STATE OF MICHIGAN)

) ss:

COUNTY OF MACOMB)

The foregoing instrument was acknowledged before me this 1st day of December, 2017 by Sam Sage, the President of Moravian Meadows Association, a Michigan Nonprofit Corporation, on behalf of the Corporation.

Colleen A. Dishman
_____, Notary Public
_____ County, Michigan
Acting in _____ County, Michigan
My Commission Expires:

Document drafted by and when recorded return to:
Stephen M. Guerra, Esq.
Makower Abbate Guerra Wegner Vollmer PLLC
30140 Orchard Lake Rd.
Farmington Hills, MI 48334


COLLEEN A. DISHMAN
NOTARY PUBLIC, STATE OF MI
COUNTY OF MACOMB
MY COMMISSION EXPIRES Dec 13, 2017
ACTING IN COUNTY OF MACOMB

CERTIFICATION

STATE OF MICHIGAN)
) SS
COUNTY OF MACOMB)


I, Sam Sage, being first duly sworn, depose and state as follows:

1. That I am the Board President of Moravian Meadows Association, the corporation named in and which executed the Amended and Restated Master Deed and Amended and Restated Condominium Bylaws of Moravian Meadows.
2. That the Amended and Restated Master Deed and Amended and Restated Condominium Bylaws of Moravian Meadows were submitted to all Co-owners of Units in Moravian Meadows for the purpose of voting on such documents, and that the Co-owners approved the documents by a vote of more than two-thirds of all Co-owners entitled to vote.



Sam Sage

Acknowledged, subscribed and sworn to before me this 1st day of December 2017.



Notary Public
County, Michigan

Acting in _____ County
My Commission Expires:


COLLEEN A. DISHMAN
NOTARY PUBLIC, STATE OF MI
COUNTY OF MACOMB
MY COMMISSION EXPIRES Dec 13, 2017
ACTING IN COUNTY OF macomb

CERTIFICATION

STATE OF MICHIGAN)
) SS
COUNTY OF OAKLAND)


I, Stephen M. Guerra, being first duly sworn, depose and state as follows:

1. That I am the attorney for Moravian Meadows Association, the Corporation named in and which executed the attached Amended and Restated Master Deed and Amended and Restated Condominium Bylaws of Moravian Meadows.
2. That I sent a copy of the attached Amended and Restated Master Deed and Amended and Restated Condominium Bylaws of Moravian Meadows and the ballot and notice required under Section 90A of the Michigan Condominium Act to all mortgagees of record of those Units qualified to vote, as listed in the records of the Macomb County Register of Deeds for the purpose of obtaining approval of said mortgagees to the Amended and Restated Master Deed and Amended and Restated Condominium Bylaws of Moravian Meadows.
3. That two-thirds (2/3rds) of said mortgages have consented to the attached Amended and Restated Master Deed and Amended and Restated Condominium Bylaws of Moravian Meadows in accordance with the provisions of Section 90A of the Michigan Condominium Act. Said consents will be maintained for a period of two years in Moravian Meadows Association records located in my office at 30140 Orchard Lake Rd., Farmington Hills, MI 48334.

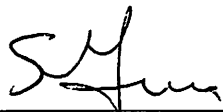

 Stephen M. Guerra

Acknowledged, subscribed and sworn to before me this 6th day of December, 2017.

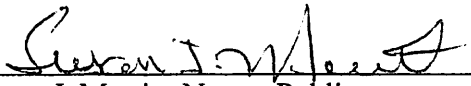

 Susan J. Merritt, Notary Public
 Wayne County, Michigan
 Acting in Oakland County
 My Commission Expires: May 23, 2020

**AMENDED AND RESTATED CONDOMINIUM BYLAWS
MORAVIAN MEADOWS**

**AMENDED AND RESTATED BYLAWS
MORAVIAN MEADOWS
TABLE OF CONTENTS**

ARTICLE I	ASSOCIATION OF CO-OWNERS.....	1
Section 1.	The Association	1
Section 2.	Purpose of Bylaws.....	1
ARTICLE II	ASSESSMENTS.....	1
Section 1.	Taxes and Assessments; Expenses of Administration	1
Section 2.	Expenses and Receipts of Administration	1
Section 3.	Determination of Assessment.....	2
Section 4.	Payment of Assessments and Penalty for Default.....	3
Section 5.	Waiver of Use or Abandonment of Unit	4
Section 6.	Enforcement	4
Section 7.	Liability of Mortgagee	5
Section 8.	Assessment Status upon Sale of Unit	6
Section 9.	Construction Liens.....	6
ARTICLE III	ARBITRATION.....	6
Section 1.	Arbitration.....	6
Section 2.	Right to Judicial Action.....	6
Section 3.	Effect of Election to Arbitrate	7
Section 4.	Mediation.....	7
ARTICLE IV	INSURANCE.....	7
Section 1.	Extent of Coverage; Responsibility for Coverage.....	7
Section 2.	Association as Attorney-in-Fact	9
Section 3.	Determination of Primary Carrier.....	9
Section 4.	Indemnification	9
ARTICLE V	RECONSTRUCTION OR REPAIR IN CASE OF CASUALTY	10
Section 1.	Determination of Reconstruction or Repair.....	10
Section 2.	Co-owner Responsibility for Reconstruction or Repair.....	10
Section 3.	Association Responsibility for Reconstruction or Repair of Common Elements ..	10
Section 4.	Timing.....	11
Section 5.	Responsibility for Amounts within Insurance Deductible or Otherwise Uninsured..	11
Section 6.	Indemnification	11
Section 7.	Eminent Domain	11
Section 8.	Rights of First Mortgagees.....	12
Section 9.	Notification to Mortgagees and Guarantors	13

ARTICLE VI	RESTRICTIONS	13
Section 1.	Use of Unit	13
Section 2.	Leasing and Rental	13
Section 3.	Alterations and Modifications	16
Section 4.	Conduct upon the Condominium	16
Section 5.	Animals within the Condominium	17
Section 6.	Use of Common Elements	18
Section 7.	Obstruction of Common Elements	18
Section 8.	Vehicles upon the Condominium	19
Section 9.	Prohibition of Dangerous Items upon the Condominium	20
Section 10.	Signs	20
Section 11.	Rules and Regulations Consistent with Condominium Act	20
Section 12.	Association Access to Units and Common Elements	20
Section 13.	Landscaping and Decoration of Common Elements	21
Section 14.	Co-owner Maintenance of Unit and Common Elements	21
Section 15.	Application of Restrictions to the Association	22
Section 16.	Cost of Enforcing Documents	22
Section 17.	Approvals Revocable	22
ARTICLE VII	MORTGAGES	22
Section 1.	Notification of Mortgage	22
Section 2.	Notification to Mortgagee of Insurance Company	22
Section 3.	Notification to Mortgagee of Meetings	23
Section 4.	Notification to Mortgagees and Guarantors	23
ARTICLE VIII	MEMBERSHIP AND VOTING	23
Section 1.	Association Membership	23
Section 2.	Voting	23
Section 3.	Action without Meeting	24
ARTICLE IX	MEETINGS	24
Section 1.	Place of Meetings	24
Section 2.	Quorum	24
Section 3.	Annual Meetings	25
Section 4.	Special Meetings	25
Section 5.	Notice of Meetings	25
Section 6.	Remote Communication Attendance; Remote Communication Meetings	25
Section 7.	Adjournment for Lack of Quorum	26
Section 8.	Minutes	26
ARTICLE X	BOARD OF DIRECTORS	26

Section 1.	Qualification and Number of Directors	26
Section 2.	Term of Directors	26
Section 3.	Powers and Duties.....	26
Section 4.	Professional Management	27
Section 5.	Vacancies	28
Section 6.	Removal of Directors	28
Section 7.	First Meeting of New Board.....	28
Section 8.	Regular Meetings	28
Section 9.	Special Meetings.....	28
Section 10.	Waiver of Notice	28
Section 11.	Quorum and Voting.....	28
Section 12.	Action without Meeting	29
Section 13.	Closing of Board of Director Meetings to Members; Privileged Minutes	29
Section 14.	Remote Communication Participation	29
Section 15.	Fidelity Bond/Crime/Employee Dishonesty Insurance	29
ARTICLE XI OFFICERS		29
Section 1.	Designation	30
Section 2.	Appointment.....	30
Section 3.	Removal	30
Section 4.	President	30
Section 5.	Vice President.....	30
Section 6.	Secretary	30
Section 7.	Treasurer	30
ARTICLE XII FINANCES, BOOKS AND RECORDS.....		30
Section 1.	Fiscal Year	30
Section 2.	Banking; Investment of Funds	30
Section 3.	Co-owner's Share of Funds.....	31
Section 4.	Association Records and Books; Audit or Review.....	31
ARTICLE XIII INDEMNIFICATION.....		31
Section 1.	Indemnification of Directors, Officers and Volunteers.....	31
Section 2.	Directors' and Officers' Insurance.....	32
ARTICLE XIV COMPLIANCE		32
Section 1.	Compliance with Condominium Documents.....	32
Section 2.	Amendment	32
Section 3.	Definitions.....	32
ARTICLE XV REMEDIES FOR DEFAULT.....		32

Section 1. Default by a Co-owner.....32
Section 2. Association's Right to Abate33
Section 3. Assessment of Fines33
Section 4. Failure to Enforce Rights33
Section 5. Cumulative Rights33
Section 6. Rights of Co-owners33
ARTICLE XVI FINES34
Section 1. General.....34
Section 2. Procedures34
Section 3. Fines34
Section 4. Collection of Fines.....35
ARTICLE XVII SEVERABILITY35

EXHIBIT A

AMENDED AND RESTATED BYLAWS MORAVIAN MEADOWS

ARTICLE I ASSOCIATION OF CO-OWNERS

Section 1. The Association. Moravian Meadows, a residential Condominium located in the Township of Clinton, Macomb County, Michigan, shall be administered by Moravian Meadows Association (the "Association"). The Association is a nonprofit corporation that has been organized under the applicable laws of the State of Michigan. The Association is responsible for the management, maintenance, operation and administration of the Common Elements, easements and affairs of the Condominium, subject to and in accordance with the Amended and Restated Consolidating Master Deed, these Amended and Restated Bylaws, the Articles of Incorporation, the Association's rules and regulations (sometimes collectively referred to as the "Condominium Documents"), and the laws of the State of Michigan. All Co-owners and all persons using or entering upon the Condominium or acquiring any interest in any Unit or the Common Elements are subject to the provisions and terms set forth in the Condominium Documents.

Section 2. Purpose of Bylaws. These Bylaws are designated as both the Condominium Bylaws, relating to the way the Condominium and the common affairs of the Co-owners of the Units shall be administered, as required by the Condominium Act, and the Association or Corporate Bylaws, governing the Association's operation as a corporate entity, as required by the Michigan Nonprofit Corporation Act.

ARTICLE II ASSESSMENTS

Section 1. Taxes and Assessments; Expenses of Administration. The Association shall be assessed as the person or entity in possession of any tangible personal property of the Condominium owned or possessed in common by the Co-owners, and personal property taxes based on such tangible personal property are expenses of administration. Special assessments levied by the government and real property taxes shall be assessed against the individual Units and not on the Common Elements or any other part of the Condominium. Special assessments levied by the government and real property taxes in any year in which the property existed as an established Condominium on the tax day shall be assessed against the individual Unit, notwithstanding any subsequent vacation of the Condominium. The government's levying of all property taxes and special assessments shall comply with Section 131 of the Condominium Act.

Section 2. Expenses and Receipts of Administration. All costs incurred by the Association in satisfaction of any liability arising within, caused by or in connection with the Common Elements or the administration of the Condominium shall be expenses of administration, and all sums received as proceeds of, or pursuant to, any policy of insurance carried by the Association securing the interests of the Co-owners against liabilities or losses arising within, caused by or connected with the Common Elements or the administration of the Condominium shall be receipts of administration, within the meaning of Section 54(4) of the Condominium Act, except as modified by the specific assignment of

responsibilities for costs contained in Article IV of the Amended and Restated Consolidating Master Deed.

Section 3. Determination of Assessment. Assessments shall be determined in accordance with the following provisions:

A. **Annual Budget.** The Association's Board of Directors shall establish an annual budget in advance for each fiscal year and such budget shall project all expenses for the forthcoming year that may be required for the proper operation, management and maintenance of the Condominium, including a reasonable allowance for contingencies and reserves. Any adopted budget shall include an allocation to a reserve fund for repairs and replacement of those Common Elements that must be replaced on a periodic basis, in accordance with subsection D below. Upon the Board of Director's adoption of an annual budget, copies of the budget shall be delivered to each Co-owner and the assessment for the year shall be established based upon that budget, although the failure to deliver a copy of the budget to each Co-owner shall not affect or in any way diminish the liability of any Co-owner for any existing or future assessments. Failure or delay of the Board of Directors to prepare or adopt a budget for any fiscal year shall not constitute a waiver or release in any manner of a Co-owner's obligation to pay the allocable share of the common expenses whenever the same shall be determined. In the absence of any annual budget or adjusted budget each Co-owner shall continue to pay each installment at the rate established for the previous fiscal year until notified of any change in the installment payment which shall not be due until at least ten (10) days after such new annual or adjusted budget is adopted. Co-owners shall have a ten (10) day grace period commencing with notice from the Board of Directors in which to submit their new or adjusted assessment payment.

B. **Additional Assessments.** The Board of Directors has the authority to increase the general assessment or to levy such additional assessments as it shall deem to be necessary in the Board's sole discretion, provided that the same shall be required for only the following: (i) to meet deficits incurred or anticipated because current assessments are insufficient to pay the costs of operation and maintenance; (ii) to provide repairs or replacements of existing Common Elements; or (iii) for any emergencies. The Board of Directors also has the authority, without the necessity of Co-owner consent, to levy assessments under Article V, Section 4 of these Amended and Restated Bylaws. The authority to levy assessments pursuant to this subsection is solely for the Association's benefit and the Co-owners and is not enforceable by any creditors of the Association or the Co-owners except that the Association may voluntarily and conditionally assign the right to levy assessments to any lender relating to any voluntary loan transaction entered into by the Association.

C. **Special Assessments.** Special assessments, in addition to those described in subsections A and B above, may be made by the Board of Directors from time to time if approved by the Co-owners as provided in this subsection, to meet other Association requirements, including, but not limited to: (i) assessments to purchase a Unit upon foreclosure of the lien for assessments described hereafter; (ii) assessments to provide additions to the Common Elements; or (iii) assessments for any other appropriate purpose not elsewhere described. Special Assessments as provided for by this subsection shall not be levied without the prior approval of more than 60% of all Co-owners in good standing. The authority to levy assessments pursuant to this subsection is solely for the Association's benefit and the Co-owners and is not enforceable by any creditors of the Association or the Co-owners except that the Association

may voluntarily and conditionally assign the right to levy assessments to any lender relating to any voluntary loan transaction entered into by the Association.

D. Reserve Fund. The Board of Directors shall maintain a reserve fund for major repairs and replacements of Common Elements and emergency expenditures, which reserve fund shall be in the amount of not less than ten percent (10%) of the Association's annual budget (excluding that portion of the budget allocated to the reserve fund itself). At least two (2) Directors must sign any checks or provide written authorization before any funds may be drawn from the reserve fund account. The Association may increase or decrease the reserve fund but may not reduce it below ten percent (10%) of the Association's annual budget. The reserve must be funded at least annually from the proceeds of the regular assessments set forth in subsection A of this Section; however, the reserve may be supplemented by additional assessments if determined necessary by the Board of Directors. The minimum standard required by this subsection may prove to be inadequate. The Board of Directors shall annually consider the needs of the Condominium to determine if a greater amount should be set aside in reserve or if additional reserve funds should be established for any other purposes. The Board may adopt such rules and regulations as it deems desirable from time to time with respect to type and manner of investment, funding of the reserves, disposition of reserves or any other matter concerning the reserve account(s). A Co-owner selling a Unit shall not be entitled to any refund whatsoever from the Association with respect to any reserve account or other Association asset.

Section 4. Payment of Assessments and Penalty for Default. All assessments levied against the Co-owners to cover expenses of administration shall be apportioned among and paid by the Co-owners equally without increase or decrease for the existence of any rights to the use of a Unit's Limited Common Elements. Annual assessments shall be payable by Co-owners in twelve (12) monthly installments or in such installments as may be provided by the Board in its sole discretion, commencing with acceptance of a deed to or a land contract vendee's interest in a Unit, or with the acquisition of fee simple title to a Unit by any other means. Additional and Special Assessments shall be payable as stated in the notice announcing their levy. The payment of an assessment shall be in default if such assessment, or any part of the assessment, is not paid to the Association in full on or before the due date for such payment, which shall be the first (1st) day of each calendar month or such other date that the Board may establish from time to time for any assessment. Assessments in default shall bear interest at the highest rate allowed by law (currently 7%) until paid in full. In addition, all assessments, or installments of assessments, that remain unpaid 5 days after the due date, shall incur a uniform late charge as may be established by the Board of Directors pursuant to Article VI, Section 11 of these Bylaws, to compensate the Association for administrative costs incurred because of the delinquency. The Board of Directors may revise the amount and frequency of uniform late charges from time to time, and may levy additional late fees for special and additional assessments, pursuant to Article VI, Section 11 of these Bylaws, without the necessity of amending these Bylaws. Once there is a delinquency in the payment of any installment of the annual assessments lasting for more than two months, the Board of Directors may accelerate the remaining unpaid installments of the annual assessment for that fiscal year so that such unpaid installments are immediately due and payable. Each Co-owner (whether one or more persons) shall be personally liable for the payment of all assessments (including late fees and costs of collection and enforcement of payment, including actual attorneys' fees) levied against their Unit while such Co-owner has an ownership interest in the Unit. Payments on installments of assessments in default shall be applied as follows: first, to costs of collection and enforcement of payment, including attorney's fees;

second, to any interest charges, fines and late fees on such installments; and third, to installments in default in order of their due dates.

Section 5. Waiver of Use or Abandonment of Unit. Co-owners shall not be exempt from liability for their contribution toward the expenses of administration by waiver of the use or enjoyment of any of the Common Elements or by the abandonment of their Unit.

Section 6. Enforcement.

A. **Statutory Lien.** Sums assessed to a Co-owner that are unpaid, together with interest on such sums, collection and late charges, advances made by the Association for taxes or other liens to protect its lien, attorneys' fees and fines (as allowed by the Condominium Documents or the Condominium Act), constitute a lien upon the Unit or Units owned by the Co-owner at the time of the assessment before other liens except tax liens on the Unit in favor of any state or federal taxing authority and sums unpaid on the first mortgage of record, except that past due assessments which are evidenced by a recorded notice of lien have priority over a mortgage recorded subsequent to the recording of the notice and affidavit of lien. The lien upon each Unit owned by the Co-owner shall be in the amount assessed against the Unit, plus a proportionate share of the total of all other unpaid assessments attributable to Units no longer owned by the Co-owner but which became due while the Co-owner had title to the Units. The lien may be foreclosed by judicial action or by advertisement in the name of the Condominium on behalf of the other Co-owners as provided below.

B. **Remedies.** The Association may enforce collection of delinquent assessments by a suit at law for a money judgment or by foreclosure of the statutory lien that secures payment of assessments, or both. A Co-owner may not withhold or escrow assessments, and may not assert in an answer, or set-off to a complaint brought by the Association for nonpayment of assessments, the fact that the Association or its agents have not provided services or management to a Co-owner. Except as provided in Article X, Section 1, a Co-owner in default shall not be qualified to run for or function as an Association officer or Director, shall not be entitled to vote so long as such default continues, and shall not be entitled to utilize any of the General Common Elements; provided, however, this provision shall not operate to deprive any Co-owner of ingress or egress to and from their Unit. The Association may also discontinue the furnishing of any utilities or services to a Co-owner in default. In a judicial foreclosure action, a receiver may be appointed to collect a reasonable rental for the Unit from the Co-owner or any persons claiming under them, and if the Unit is not occupied by the Co-owner, to lease the Unit and collect and apply the rents received. The Association may also assess fines for late payment or nonpayment of assessments in accordance with the provisions of Article XVI of these Bylaws. All remedies shall be cumulative and not alternative.

C. **Foreclosure of Lien.** Each Co-owner, and every other person who from time to time has any interest in the Condominium, shall be deemed to have granted to the Association the unqualified right to elect to foreclose the lien securing payment of assessments, costs and expenses, either by judicial action or by advertisement. The provisions of Michigan law pertaining to foreclosure of mortgages by judicial action and by advertisement, and the provisions of Section 108 of the Condominium Act, as the same may be amended from time to time, are incorporated by reference for the purposes of establishing the alternative procedures to be followed in lien foreclosure actions and the rights and obligation of the parties to such actions. Further, each Co-owner and every other person who from time to time has any

interest in the Condominium, shall be deemed to have authorized and empowered the Association to sell or to cause to be sold the Unit (and improvements) with respect to which assessments are delinquent and to receive, hold and distribute the proceeds of such sale in accordance with the priorities established by applicable law. Each Co-owner acknowledges that at the time of acquiring title to such Unit they were notified of the provisions of this Section 6 and that they voluntarily, intelligently and knowingly waived notice of any proceedings brought by the Association to foreclose by advertisement the lien for nonpayment of assessments and a hearing on the same prior to the sale of the subject Unit.

D. Notice of Action. Notwithstanding the foregoing, neither a judicial foreclosure action nor a suit at law for a money judgment shall be commenced, nor shall any notice of foreclosure by advertisement be published, until the expiration of ten (10) days after mailing by first class mail, postage prepaid, addressed to the delinquent Co-owner at their last known address, of a written notice that one or more installments of the annual, additional or special assessment, as the case may be, levied against the pertinent Unit is or are delinquent and that the Association may invoke any of its remedies under this Article II if the default is not cured within ten (10) days after the date of mailing. Such written notice shall be accompanied by a written affidavit of an authorized Association representative that sets forth (i) the affiant's capacity to make the affidavit, (ii) the statutory and other authority for the lien, (iii) the amount outstanding (exclusive of interest, costs, attorneys' fees and future assessments), (iv) the legal description of the subject Unit, and (v) the name of the Co-owner of record. Such affidavit shall be recorded in the Macomb County Register of Deeds prior to the commencement of any foreclosure proceeding, but it need not have been recorded as of the date of mailing to the delinquent Co-owner. If the delinquency is not cured within the ten (10) day period, the Association may take such remedial action as may be available to it under the Condominium Documents or under Michigan law. In the event the Association elects to foreclose the lien by advertisement, the Association shall notify the Co-owner and shall inform the Co-owner that they may request a judicial hearing by bringing suit against the Association.

E. Expenses of Collection. All expenses incurred in collecting unpaid assessments, including interests, fines, costs, actual attorneys' fees (not limited to statutory fees and including attorneys' fees and costs incurred incidental to any bankruptcy proceedings filed by the delinquent Co-owner or probate or estate matters, including monitoring any payments made by the bankruptcy trustee or the probate court or estate to pay any delinquency, and/or attorneys' fees and costs incurred incidental to any State or Federal Court proceeding filed by the Co-owner) and advances for taxes or other liens or costs paid by the Association to protect its lien, shall be chargeable to the Co-owner in default and shall be secured by the lien on their Unit.

Section 7. Liability of Mortgagee. Notwithstanding any other provisions of the Condominium Documents, the holder of any first mortgage covering a Unit, or such first mortgage holder's successors and assigns, that obtains title to the Unit pursuant to the foreclosure remedies provided in the mortgage, shall take the property free of any claims for unpaid assessments or charges against the mortgaged Unit which become due prior to the acquisition of title to the Unit (the date of the foreclosure sale) by such person or entity, except for claims for a pro rata share of such assessments or charges resulting from a pro rata reallocation of such assessments or charges to all Units including the mortgaged Unit, and except for claims evidenced by a Notice of Lien recorded prior to the recording of the first mortgage.

Section 8. Assessment Status upon Sale of Unit. Upon the sale or conveyance of a Unit, any unpaid assessments, interest, late fees, fines, costs and attorneys' fees against the Unit shall be paid out of the net proceeds of the sale price or by the purchaser in preference over any other assessments or charges of whatever nature except (a) amounts due the State of Michigan or any subdivision of the State for taxes or special assessments due and unpaid and (b) payments due under first mortgages having priority to the unpaid assessments. A purchaser or grantee of a Unit is entitled to a written statement from the Association setting forth the amount of unpaid assessments, interest, late fees, fines, costs and attorneys' fees outstanding against the Unit and the purchaser is not liable for any unpaid assessments, interest, late fees, fines, costs and attorneys' fees in excess of the amount set forth in such written statement, nor shall the Unit be subject to any lien for any amounts in excess of the amount set forth in the written statement. Any purchaser or grantee who fails to request a written statement from the Association at least five (5) days before the conveyance shall be liable for any unpaid assessments against the Unit together with interest, late fees, fines, costs and attorneys' fees incurred in connection with the collection of such assessments.

Section 9. Construction Liens. Construction liens attaching to any portion of the Condominium are subject to the following limitations and Section 132 of the Condominium Act:

A. Except as otherwise provided, a construction lien for work performed upon a Unit or upon a Limited Common Element may attach only to the Unit upon which the work was performed.

B. A construction lien for work authorized by the Association may attach to each Unit only to the proportionate extent that the Co-owner of the Unit is required to contribute to the expenses of administration as provided by the Condominium Documents.

C. A construction lien may not arise or attach to a Unit for work performed on the Common Elements not contracted for by the Association.

ARTICLE III ARBITRATION

Section 1. Arbitration. Disputes, claims, or grievances arising out of or relating to the interpretation or the application of the Condominium Documents, or any disputes, claims or grievances arising among or between Co-owners, or between a Co-owner or Co-owners and the Association shall, upon the election and written consent of the parties to any such disputes, claims or grievances and written notice to the Association, if applicable, be submitted to arbitration under the procedures set forth in the Uniform Arbitration Act and parties to the arbitration shall accept the arbitrator's decision as final and binding. The Commercial Arbitration Rules of the American Arbitration Association as amended and in effect from time to time shall be applicable to any such arbitration.

Section 2. Right to Judicial Action. In the absence of the election and written consent of the parties pursuant to Section 1 above, neither a Co-owner nor the Association is precluded from petitioning the courts to resolve any disputes, claims or grievances.

Section 3. Effect of Election to Arbitrate. Election by the parties to submit any such dispute, claim or grievance to arbitration precludes such parties from litigating such dispute, claim or grievance in the courts.

Section 4. Mediation. Regardless of the other remedies available under these Bylaws or the Condominium Act, the parties to any dispute may agree to mediate any disputes. In instances involving a dispute between two or more Co-owners that has been presented to the Association by such Co-owners, the Association may compel the disputing Co-owners to first mediate the dispute before the Association considers any other action. All compelled mediation shall be conducted by qualified outside mediators at the expense of the disputing Co-owners. In all other instances, mediation is totally voluntary and upon agreement of the disputing parties.

ARTICLE IV INSURANCE

Section 1. Extent of Coverage; Responsibility for Coverage.

A. Association Responsibilities.

(1) **Casualty.** The Association shall insure all Common Elements that the Association has responsibility for repairing and replacing under Article IV, Section 2 of the Amended and Restated Consolidating Master Deed against fire, vandalism, malicious mischief, and other perils covered by a standard extended coverage endorsement, in an amount equal to one hundred percent (100%) of the current replacement cost of the insurable improvements, excluding foundation and excavation costs, as determined annually by the Association's Board of Directors. The Association's policy shall include a "Guaranteed Replacement Cost Endorsement" or a "Replacement Cost Endorsement" and, if the policy includes a coinsurance clause, an "Agreed Amount Endorsement." The policy shall also include an "Inflation Guard Endorsement," if available, and a "Building Ordinance and Law Endorsement." The Association may also insure as secondary coverage those Common Elements that Co-owners are assigned repair and replacement responsibility under Article IV, Section 2 of the Amended and Restated Consolidating Master Deed, as well as Unit interior wall construction and any pipes, wires, conduits or ducts contained within the Unit interior walls.

(2) **Liability, Worker's Compensation, Fidelity Bond, Directors and Officer, and Other Required Coverage.** The Association shall also carry (1) liability insurance with coverage in the minimum amount of one million dollars (\$1,000,000.00) for a single occurrence pertinent to the ownership, use, and maintenance of the Common Elements that the Association has responsibility for repairing and replacing under Article IV, Section 2 of the Amended and Restated Consolidating Master Deed, (2) worker's compensation insurance, if applicable, (3) fidelity bond or equivalent employee dishonesty/crime coverage in the minimum amount of a sum equal to three months aggregate assessments on all Units plus reserve funds on hand, with such fidelity bond or equivalent employee dishonesty/crime insurance covering all Association officers, directors, and employees and all other persons, including any management agent, handling or responsible for any monies received by or payable to the Association (it being understood that if the management agent or others cannot be added to the Association's coverage, they shall be responsible for obtaining the same type and amount of coverage on their own before handling any Association funds), (4) Directors and Officers Liability coverage, and (5) such other insurance as the Board of Directors deems advisable.

(3) Optional Umbrella Insurance. The Association may purchase as an expense of administration an umbrella insurance policy that covers any risk the Association is required to cover but was not covered due to lapse or failure to procure.

(4) Benefited Parties; Notice to Mortgagees. All such insurance shall be purchased by the Association for the Association's benefit, the Co-owners, and their mortgagees, as their interests may appear, and provisions shall be made for the issuance of certificates of mortgagee endorsements to the mortgagees of Co-owners.

(5) Insurance Records. All non-sensitive and non-confidential information in the Association's records regarding Common Element insurance coverage shall be made available to all Co-owners and mortgagees upon written request and reasonable notice during normal business hours.

(6) Cost of Insurance. All premiums for insurance purchased by the Association shall be expenses of administration.

(7) Proceeds of Association Insurance Policies. Proceeds of all Association insurance policies shall be received by the Association, held in a separate account and distributed to the Association, the Co-owners and their mortgagees as their interests may appear; provided, however, whenever repair or reconstruction of the Condominium is required as provided in Article V of these Bylaws, the proceeds of any insurance that the Association receives as a result of any loss requiring repair or reconstruction shall be applied for such repair or reconstruction.

B. Co-owner Responsibilities. Co-owners are advised that the Association's coverage is not intended to be complete as to all matters, and the Co-owners have an obligation to provide certain coverage as outlined in this Article. Co-owners are advised to consult with their insurance advisors to determine what additional insurance they must obtain upon their Units and Common Elements at their own expense in addition to the coverage carried by the Association. Each Co-owner shall obtain insurance coverage for (i) those Common Elements that the Co-owner is assigned repair and replacement responsibility under Article IV, Section 2 of the Amended and Restated Consolidating Master Deed, (ii) the interior of their Unit, including all fixtures, equipment, and trim located within the Unit, (iii) personal property located within a Unit or elsewhere in the Condominium, (iv) all improvements and betterments to the Unit and Limited Common Elements, (v) personal liability and property damage for occurrences within a Unit or upon its Limited Common Elements and for General Common Elements that the Co-owner is assigned responsibility under Article IV, Section 2 of the Amended and Restated Consolidating Master Deed, and (vi) alternative living expense in event of fire or other casualty, and the Association has absolutely no responsibility for obtaining such coverage. All Common Elements that Co-owners are required to insure shall be insured against fire, vandalism, malicious mischief and other perils in an amount equal to 100% of the current replacement cost. Co-owners are also advised to obtain insurance covering any insurance deductible or uninsured amount that the Co-owner may be required to pay under Article V, Section 5 or Article VI, Section 14 of these Bylaws. Each Co-owner shall deliver certificates of insurance to the Association as the Board of Director's may require from time to time to evidence the continued existence of all insurance that Co-owners are required to maintain. In the event a Co-owner fails to obtain such insurance or to provide evidence of such insurance to the Association, the Association may, but is not required to, obtain such insurance on behalf of such Co-owner and the premiums paid shall constitute a lien against the Co-owner's Unit and may be collected from the Co-

owner in the same manner that Association assessments may be collected under Article II of these Amended and Restated Bylaws.

C. Waiver of Subrogation; Cross-Liability Endorsements. The Association and all Co-owners shall use their best efforts to see that all property and liability insurance carried by the Association or any Co-owner contains appropriate provisions whereby the insurer waives its right of subrogation as to any claims against any Co-owner or the Association. The Association's liability insurance shall, where appropriate, contain cross-liability endorsements to cover liability of the Co-owners as a group to another Co-owner.

Section 2. Association as Attorney-in-Fact. Each Co-owner is deemed to appoint the Association as their true and lawful attorney-in-fact to act regarding all matters concerning any insurance carried by the Association. Without limiting the generality of the previous sentence, the Association has full power and authority to purchase and maintain such insurance, to collect and remit premiums, to collect proceeds and to distribute the same to the Association, the Co-owners and respective mortgagees, as their interests may appear, but subject to the Condominium Documents, to execute releases of liability, and to execute all documents and to do all things on behalf of such Co-owner and the Condominium as necessary or convenient to the accomplishment of the foregoing.

Section 3. Determination of Primary Carrier. It is understood that there may be overlapping coverage between the Co-owners' and Association's policies. In situations where both the Association's coverage and a Co-owner's coverage apply to a given loss, the provisions of this subsection control in determining the primary carrier. In cases of (a) liability for personal injury or otherwise, which relate to occurrences in the Unit or upon a Common Element that the Co-owner is assigned repair and replacement responsibility under Article IV, Section 2 of the Amended and Restated Consolidating Master Deed, or (b) property damage to the Unit and its contents or to any Common Element or other element or property that the Co-owner is assigned repair and replacement responsibility under Article IV, Section 2 of the Amended and Restated Consolidating Master Deed, or (c) incidental or consequential damages to any other Unit resulting from an item, element, or occurrence for which the Co-owner is assigned repair and replacement responsibility under Article IV of the Amended and Restated Consolidating Master Deed, the Co-owner's policy shall be deemed to be primary. In cases of (a) liability for personal injury or otherwise, which relate to occurrences on Common Elements for which the Association is assigned repair and replacement responsibility under Article IV of the Amended and Restated Consolidating Master Deed, or (b) property damage to a Common Element for which the Association is assigned repair and replacement responsibility under Article IV, Section 2 of the Amended and Restated Consolidating Master Deed, the Association's policy shall be deemed to be primary. In all cases where the Association's policy is not deemed the primary coverage, if the Association's insurance provider contributes to payment of the loss, the Association's liability to the Co-owner is limited to the amount of the insurance proceeds. In cases where the Co-owner's policy is deemed primary for covering losses where the damage is incidental or caused by a Common Element or the repair or replacement of a Common Element, the Co-owner's insurance carrier has no right of subrogation against the Association or its carrier.

Section 4. Indemnification. Each Co-owner shall indemnify and hold harmless the Association for all damages and costs, including attorneys' fees, which the Association may suffer as a result of defending any claim arising out of an occurrence for which the individual Co-owner is required

to carry coverage pursuant to this Article, and shall carry insurance to secure this indemnity if so required by the Association. This Section shall not be construed to give any insurer any subrogation right or other right or claim against any individual Co-owner.

ARTICLE V RECONSTRUCTION OR REPAIR IN CASE OF CASUALTY

Section 1. Determination of Reconstruction or Repair. If the damaged property is a Common Element or a Unit, the property shall be rebuilt or repaired if any Unit is tenantable, unless it is determined by the affirmative vote of eighty percent (80%) of the Co-owners that the entire Condominium shall be terminated, and two-thirds (2/3rds) of all mortgagees of record have consented to such termination, which mortgagee consent shall be solicited in accordance with Section 90a of the Condominium Act.

Section 2. Co-owner Responsibility for Reconstruction or Repair. Subject to the provisions of Article VI, Section 14, regardless of the cause or nature of any damage or deterioration, including, but not limited to, instances in which the damage is incidental to or caused by (i) a Common Element for which the Association is responsible under Article IV of the Amended and Restated Consolidating Master Deed, (ii) the maintenance, repair, or replacement of any Common Element, (iii) the Co-owner's own actions or the Co-owner's failure to take appropriate preventive action, or (iv) the malfunction of any appliance, equipment, or fixture located within or serving the Unit, each Co-owner shall be responsible for the cost of repair, reconstruction and replacement of all items the Co-owner is assigned repair and replacement responsibility under Article IV, Section 2 of the Amended and Restated Consolidating Master Deed, and for those items that the Co-owner is primarily responsible to insure under Article IV of these Amended and Restated Bylaws. If the damage is only to an item that is the Co-owner's responsibility to repair, replace and insure, it shall be the Co-owner's responsibility to promptly repair such damage in accordance with these provisions. If the damage involves items that are both the Co-owner's and the Association's responsibility to repair, replace and insure, then the Association is responsible for reconstruction or repair in accordance with Section 3 of this Article, although the responsibility for costs shall be allocated in accordance with the provisions of this Section and Section 3. If any interior portion of a Unit is covered by insurance held by the Association for the benefit of the Co-owner, and the Association's carrier is responsible for paying a claim under Article IV of these Amended and Restated Bylaws, the Co-owner is entitled to receive those proceeds of insurance, but only in the absence of Co-owner coverage for those items, and those proceeds shall be used solely for necessary repairs.

Section 3. Association Responsibility for Reconstruction or Repair of Common Elements. Subject to the responsibility of the individual Co-owners as outlined in Section 2 above and other provisions of these Bylaws or the Amended and Restated Consolidating Master Deed applicable to such situations, the Association is responsible for the reconstruction and repair of those items the Association is assigned repair and replacement responsibility under Article IV, Section 2 of the Amended and Restated Consolidating Master Deed, and for those items that the Association is primarily responsible to insure under Article IV of these Bylaws. Under no circumstances will the Association be responsible for incidental or consequential damages to a Unit, Limited Common Element, or any other property that is the responsibility of a Co-owner, or to the contents of any Unit or the personal property of a Co-owner or Unit occupant. Immediately after a casualty causing damage to property for which the Association has the responsibility of maintenance, repair, or reconstruction, the Association shall obtain reliable and

detailed estimates of the cost to place the damaged property in a condition as good as that existing before the damage.

Section 4. Timing. If damage to Common Elements or a Unit adversely affects the appearance of the Condominium or deprives others from utilizing the Common Elements, the party responsible for the repair and reconstruction shall promptly proceed with the repair or replacement of the damaged property.

Section 5. Responsibility for Amounts within Insurance Deductible or Otherwise Uninsured. Notwithstanding any other provision of the Condominium Documents, and except to the extent that a lack of insurance results from a breach of the Association's or other Co-owner's duty to insure, the responsibility for damage to any portion of the Condominium that is within the limits of any applicable insurance deductible, unless waived, and for any other uninsured amount, shall be borne by the responsible Co-owner whenever the damage is the result of a failure to observe or perform any requirement of the Condominium Documents, or if the damage results from damage to or misuse of any of the Common Elements by the Co-owner, or their family, guests, agents, or invitees, or by casualties and occurrences, whether or not resulting from Co-owner negligence, involving items or Common Elements which are the responsibility of the Co-owner to maintain, repair, or replace.

Section 6. Indemnification. Each Co-owner shall indemnify and hold the Association harmless for all damages and costs, including, without limitation, actual attorneys' fees (not limited to reasonable attorneys' fees), which the Association suffers as the result of defending any claim arising out of an occurrence on or within such Co-owner's Unit or a Common Element for which the Co-owner is assigned the responsibility to maintain, repair, or replace. Each Co-owner shall carry insurance to secure this indemnity. This Section shall not be construed to afford any insurer any subrogation right or other claim or right against a Co-owner.

Section 7. Eminent Domain. Section 133 of the Condominium Act (to the extent not inconsistent with the following) and the following provisions shall control upon any taking by eminent domain:

A. **Common Elements Taken by Eminent Domain.** If any portion of the Common Elements is taken by eminent domain, the award shall be allowed to the Co-owners in proportion to their respective undivided interests in the Common Elements. The Association, acting through its Board of Directors, may negotiate on behalf of all Co-owners for any taking of the Common Elements and any negotiated settlement approved by more than two-thirds (2/3) of the Co-owners shall be binding on all Co-owners.

B. **Unit Taken by Eminent Domain.** If a Unit is taken by eminent domain, the undivided interest in the Common Elements appertaining to the Unit shall appertain to the remaining Units, being allocated to them in proportion to their respective undivided interests in the Common Elements. The court shall enter a decree reflecting the reallocation of the undivided interest in the Common Elements as well as for the Unit.

C. **Partial Taking of a Unit.** If portions of a Unit are taken by eminent domain, the court shall determine the fair market value of the portions of the Unit not taken. The undivided interest of such Unit in the Common Elements shall be reduced in proportion to the diminution in the fair market

value of such Unit resulting from the taking. The portions of undivided interest in the Common Elements thereby divested from the Co-owners of such Unit shall be reallocated among the other Units in proportion to their respective undivided interests in the Common Elements. A Unit partially taken shall receive the reallocation in proportion to its undivided interest as reduced by the court under this subsection. The court shall enter a decree reflecting the reallocation of undivided interests produced thereby, and the award shall include just compensation to the Co-owner of the Unit partially taken for that portion of the undivided interest in the Common Elements divested from the Co-owner and not revested in the Co-owner pursuant to the following subsection, as well as for that portion of the Unit taken by eminent domain.

D. Impossibility of Use of Portion of Unit Not Taken by Eminent Domain. If the taking of a portion of a Unit makes it impractical to use the remaining portion of that Unit for a lawful purpose permitted by the Condominium Documents, then the entire undivided interest in the Common Elements appertaining to that Unit shall appertain to the remaining Units, being allocated to them in proportion to their respective undivided interests in the Common Elements. The remaining portion of that Unit shall be a Common Element. The court shall enter an order reflecting the reallocation of undivided interests produced thereby, and the award shall include just compensation to the Co-owner of the Unit for the Co-owner's undivided interest in the Common Elements and for the entire Unit.

E. Future Expenses of Administration Appertaining to Units Taken by Eminent Domain. Votes in the Association and liability for future expenses of administration appertaining to a Unit taken or partially taken by eminent domain shall appertain to the remaining Units, being allocated to them in proportion to their relative voting strength in the Association. A Unit partially taken shall receive a reallocation as though the voting strength in the Association was reduced in proportion to the reduction in the undivided interests in the Common Elements.

F. Condominium Continuation after the taking by Eminent Domain. In the event the Condominium continues after a taking by eminent domain, then the remaining portion of the Condominium shall be resurveyed and the Amended and Restated Consolidating Master Deed amended accordingly. Such amendment may be effected by an Association officer duly authorized by the Board of Directors without the necessity of execution or specific approval by any Co-owner, but only with the prior written approval of holders of two-thirds (2/3rds) of all first mortgage liens on individual Units.

G. Condemnation or Eminent Domain Proceeding. In the event any Unit, or any portion of a Unit, or the Common Elements, or any portion of the Common Elements, is made the subject matter of any condemnation or eminent domain proceeding or is otherwise sought to be acquired by a condemning authority, the Association shall promptly notify each institutional holder of a first mortgage lien on any of the Units.

Section 8. Rights of First Mortgagees. Nothing contained in the Condominium Documents shall be construed to give a Co-owner, or any other party, priority over any rights of first mortgagees of Units pursuant to their mortgages in the case of a distribution to Co-owners of insurance proceeds or condemnation awards for losses to or a taking of Units or Common Elements.

Section 9. Notification to Mortgagees and Guarantors. Upon written request submitted to the Association, the Association shall give the holder of any first mortgage and any guarantors of the

mortgage covering any Unit timely written notice of any condemnation or casualty loss that affects either a material portion of the Condominium or the Unit securing the mortgage.

ARTICLE VI RESTRICTIONS

Section 1. Use of Unit.

A. Single Family Use. No Unit shall be used for other than single-family residential purposes as defined by Township of Clinton Zoning Ordinances, and the Common Elements shall be used only for purposes consistent with such use. No Co-owner shall carry on any business enterprise or commercial activities anywhere on the Common Elements or within the Units, including without limitation for profit or nonprofit day care, adult foster care, nursing facilities, transitional housing and similar enterprises; provided, however, that Co-owners shall be allowed to have home offices in their Units so long as the same (1) do not involve additional pedestrian or vehicular traffic by customers, users or beneficiaries of the services being performed and/or congestion within the Condominium, (2) do not utilize or involve the presence of any employees within the Unit other than the individual Co-owner(s) and their families, (3) do not disturb other Co-owners, (4) do not involve additional expense to the Association (such as utility charges and insurance), and (5) do not violate any other provision or restriction contained in the Condominium Documents, (6) do not involve the storage of bulk goods for resale, and (7) do not constitute a violation of any ordinances or regulations of the Township of Clinton.

B. Occupancy Restrictions. The number of persons allowed to occupy or reside in any Unit shall be governed by the restrictions and regulations of the Building Officials and Code Administrators National Property Maintenance Code or such other codes or ordinances that may be adopted by the Township of Clinton from time to time governing occupancy. Such restrictions shall automatically change, without the necessity of an amendment to these Bylaws, upon the adoption of alternative regulations by the Township of Clinton, such that all Unit occupancy shall be in accordance with all Township of Clinton regulations.

Section 2. Leasing and Rental.

A. Right to Lease.

(1) A Co-owner may only lease a Unit for the same purposes as set forth in Article VI, Section 1, and only if the Co-owner (a) is in compliance with this Section 2, (b) has followed the disclosure procedures contained in subsection B below, and (c) obtained the Board of Director's prior written approval as more fully set forth in this Section 2.

(2) Except for those Units under an approved lease as of the effective date of the Amended and Restated Consolidating Master Deed, the Board of Directors shall not grant approval if the leasing of such Unit would cause the total number of leased Units in the Condominium to exceed 10%.

(3) Subject to the provisions of subsections (1) and (2), no Co-owner shall lease less than an entire Unit, and all leases shall (i) be for an initial term of no less than six (6) months, (ii) require

the lessee to comply with the Condominium Documents, and (iii) provide that failure to comply with the Condominium Documents constitutes a default under the lease.

(4) No Co-owner shall accommodate transient tenants or occupants. For purposes of this Section, "transient tenant or occupant" refers to a non-Co-owner occupying a Unit for less than sixty (60) days and who has paid consideration for the occupancy.

(5) The terms of all leases, occupancy agreements and occupancy arrangements shall incorporate, or be deemed to incorporate, all the Condominium Document provisions. The Association may require the use of a standard lease addendum to ensure compliance with the requirements of this Section.

B. Procedures for Leasing. The leasing of Units shall conform to the following additional provisions:

(1) Disclosure. A Co-owner desiring to rent or lease a Unit, shall disclose that fact in writing to the Association at least ten (10) days before presenting a lease form to a potential lessee, and shall at the same time supply the Association with a copy of the exact lease form for its review for its compliance with the Condominium Documents. Each Co-owner shall, promptly following the execution of any approved lease of a Unit, forward a true copy of the fully executed lease to the Association. If no lease form is to be used, then the Co-owner shall supply the Association with the name and address of the potential lessee or other occupants, along with the amount and due dates of any rental or compensation payable to the Co-owner, and the term of the proposed occupancy arrangement. Co-owners who do not live in their Unit must keep the Association informed of their current correct address and phone number.

(2) Administrative Fee. The Board of Directors may charge such reasonable administrative fees for reviewing, approving and monitoring lease transactions in accordance with this Section as the Board may establish. Any such administrative fees shall be assessed to and collected from the leasing Co-owner in the same manner as the collection of assessments under Article II of these Amended and Restated Bylaws.

(3) Compliance with Condominium Documents. Tenants or non-Co-owner occupants shall comply with the Condominium Documents.

(4) Default by Tenant or Non-Co-owner Occupant. If the Board determines that a tenant or non-Co-owner occupant failed to comply with the Condominium Documents, the Association shall take the following action:

(a) Notification. The Association shall notify the Co-owner by certified mail advising of the alleged violation.

(b) Time to Cure. The Co-owner has fifteen (15) days after receipt of such notice to investigate and correct the alleged tenant or non-Co-owner occupant breach or advise the Association that a violation has not occurred.

(c) Remedies. If after fifteen (15) days the Association believes that the alleged breach is not cured or may be repeated, it may institute on its behalf or derivatively by the Co-owners on behalf of the Association an action for eviction against the tenant or non-Co-owner occupant for breach of the Condominium Documents. The relief set forth in this Section may be by summary proceeding, although the Association may pursue relief in any Court having jurisdiction and whether by summary proceeding or otherwise. The Association may hold the tenant, the non-Co-owner occupant and the Co-owner liable for any damages caused by the Co-owner, tenant or non-Co-owner occupants. The Co-owner shall be responsible for reimbursing the Association for all costs incurred because of a tenant's or non-Co-owner occupant's failure to comply with the Condominium Documents, including the pre-litigation costs and actual attorneys' fees incurred in obtaining their compliance with the Condominium Documents.

(5) Notice to Pay Rent Directly to Association. When a Co-owner is in arrears to the Association for assessments, the Association may give written notice of the arrearage to the Co-owner's tenant or non-Co-owner occupant and the tenant or non-Co-owner occupant after receiving the notice shall deduct from their rental payments to the Co-owner the arrearage and future assessments as they fall due and shall pay them to the Association. The deductions shall not be a breach of the rental agreement or lease by the tenant or non-Co-owner occupant. If the tenant or non-Co-owner occupant, after being so notified, fails or refuses to remit rent to the Association that is otherwise due the Co-owner, then the Association may (1) prohibit the tenant from utilizing any of the General Common Elements, (2) issue a statutory Notice to Quit for non-payment of rent, and enforce that notice by summary proceedings, and/or (3) initiate proceedings pursuant to Section 112(4)(b) of the Condominium Act.

D. Lender Exception. Notwithstanding anything to the contrary and except for the prohibition on transient tenancies, first mortgage lenders or first mortgagee guarantors in possession of a Unit following a default of a first mortgage, foreclosure, or deed or other arrangement in lieu of foreclosure shall not be subject to the restrictions contained in Section 2A above and which relate to the term of any lease or rental agreement.

E. Department of Veterans Affairs Exception. To the extent that any provision set forth in the Condominium Documents regarding leasing is inconsistent with the requirements of guaranteed or direct loan programs of the United States Department of Veterans Affairs, as set forth in chapter 37 of title 38, United States Code, or part 36 of title 38, Code of Federal Regulations ("DVA Financing"), such provision shall not apply to any Unit that is:

- (1) Encumbered by DVA Financing; or
- (2) Owned by the Department of Veterans Affairs.

F. Rent Loss Insurance Coverage. Those Co-owners that rent their Unit are advised to obtain insurance coverage for reimbursement of rental income that may be lost while the Unit is being repaired, rebuilt or is otherwise not capable of being occupied. The Association shall have absolutely no responsibility for obtaining such coverage and Co-owners shall have absolutely no claim against the Association for lost rental income.

Section 3. Alterations and Modifications.

A. Approvals Required. No Co-owner may commence or make alterations in exterior appearance or make structural modifications to any Unit including interior walls through or in which there exist easements for support or utilities or make changes in the appearance or use of any of the Common Elements, including but not limited to, exterior painting, replacement of windows or doors, or the erection of lights, awnings, shutters, newspaper holders, mailboxes, spas, hot tubs, decks, patios, structures, fences, walls or other exterior attachments or modifications, until plans and specifications acceptable to the Board showing the nature, kind, shape, height, materials, color scheme, location and approximate cost has first been submitted to and approved in writing by the Board, and a copy of such plans and specifications, as finally approved, delivered to the Board. The Board has the right to refuse to approve any such plans or specifications that are not suitable or desirable in its opinion for aesthetic or any other reasons, and in passing upon such plans and specifications it has the right to take into consideration the suitability of the proposed structure, improvement or modification, the area upon which it is proposed to be constructed, and the degree of harmony with the entire Condominium. In the event the Board approves any modification or alteration application, such approval is subject to a recordable, written undertaking by the Co-owner acknowledging that installation, maintenance, repair, replacement and insuring of all the improvements are to be at the Co-owner's sole expense. The Board has the right to require a Co-owner to complete the installation of any approved improvements or modifications by a date certain. Any modifications or alterations that a Co-owner performs pursuant to this Section shall, if applicable, be performed by licensed and insured contractors and in accordance with all applicable governmental regulations and ordinances, including the requirement that proper permits be applied for and issued by appropriate governmental agencies.

B. Improvements or Modifications to Facilitate Access to or Movement within a Unit. The provisions contained in subsection A are subject to the applicable Condominium Act provisions governing improvements or modifications if the purpose of the improvement or modification is to facilitate access to or movement within the Unit for persons with disabilities under the circumstances provided for in the Condominium Act at MCL 559.147a, as may be amended from time to time.

C. Sound Conditioning. A Co-owner shall not damage, attach anything to, or alter walls between Units so as to compromise sound conditioning.

D. Installation of Antennas/Satellite Dishes. The installation of antennas, direct broadcast satellites and other technologies regulated by the Federal Communications Commission shall be in accordance with duly promulgated Association rules and regulations, which shall always be construed so as not to violate applicable FCC regulations.

Section 4. Conduct upon the Condominium. No harmful, improper or unlawful activity, including without limitation speeding or other vehicular infractions, shall be engaged in on or upon the Common Elements or any Unit, nor shall anything be done which may be or become an annoyance or a nuisance to the Co-owners, nor shall any unreasonably noisy activity be carried upon the Common Elements or any Unit. There shall not be maintained any device or thing of any sort whose normal activities or existence is in any way harmful, noisy, dangerous, unsightly, unpleasant or of a nature as may diminish or destroy the reasonable enjoyment of other Units. No Co-owner shall do or permit anything to be done or keep or permit to be kept on their Unit or on the Common Elements anything

that will increase the rate of insurance on the Condominium without the Board's written approval and each Co-owner shall pay to the Association the increased cost of insurance premiums resulting from any such activity or the maintenance of any such condition. All municipal codes and ordinances pertaining to the use of the Common Elements must always be followed.

Section 5. Animals within the Condominium.

A. Number and Type. No more than 2 household pets shall be kept, maintained or allowed within any Unit. The term "animal" or "pet" as used in this section shall not include small animals, fish or birds that are constantly caged or in a tank. Exotic pets (i.e. rare or unusual animals or animals generally thought of as wild and not typically kept as a pet) are strictly prohibited.

B. Restrictions Applicable to Pets; Responsibilities of Co-owners.

(1) The Board of Directors may require that Co-owners register their pets with the Association before the pet may be maintained on or within the Condominium. The Board may require that any such registration include, among other things, a complete description of the pet, its name, the name and telephone number of the adult person responsible for the pet, and the name, address and telephone number of the veterinarian or veterinary clinic which maintains the pet's health and immunization records, and a current picture.

(2) No animals may be kept or bred for any commercial purpose. Any pets permitted to be kept in the Condominium shall have such care and restraint as not to be obnoxious because of noise, odor or unsanitary conditions.

(3) No pet may be permitted to be housed outside of a Unit, in a pen or otherwise, nor shall pets be tied or restrained outside or be allowed to be loose upon the Common Elements. All pets shall be leashed when outdoors with the leash being held and controlled by a responsible person and otherwise in accordance with any Township of Clinton Ordinances that may apply.

(4) Each Co-owner shall be responsible for the immediate collection and disposition of all fecal matter deposited by any pet maintained by such Co-owner, anywhere in the Condominium.

(5) No savage or dangerous animal of any type shall be kept and any Co-owner who causes any animal to be brought, maintained or kept on the Condominium for any length of time shall indemnify and hold harmless the Association for any loss, damage or liability, including attorneys' fees and costs, which the Association may sustain because of the presence of such animal on the Condominium, whether such animal is permitted or not. The Association may assess and collect from the responsible Co-owner such losses and damages in the manner provided in Article II of these Amended and Restated Bylaws. No animal that creates noise and can be heard on any frequent or continuing basis shall be kept in any Unit or on the Common Elements.

(6) The Association may charge Co-owners maintaining animals a reasonable additional assessment to be collected in the manner provided in Article II if the Board determines such assessment necessary to defray the maintenance costs to the Association of accommodating animals within the Condominium.

(7) All animals kept in accordance with this Section shall be licensed by the municipal agency having jurisdiction, and proof of the animal's shots shall be provided to the Association upon request.

C. Association Remedies. The Association may, after notice and hearing and without liability, remove or cause to be removed any animal from the Condominium that the Board determines to be in violation of the restrictions imposed by this Section or by any applicable Association rules and regulations. The Board may also assess fines for any such violations. The Board may adopt such additional reasonable rules and regulations with respect to animals, as it may deem proper.

Section 6. Use of Common Elements. Co-owners and other users of the Condominium shall not use the Common Elements for storage of supplies, materials, personal property or trash or refuse of any kind, except as provided in the Condominium Documents. Trash receptacles shall be maintained in Board-designated areas and shall not be permitted to remain elsewhere on the Common Elements except for such short periods of time as may be reasonably necessary to permit periodic collection of trash. Trash shall be stored and handled in accordance with all applicable Association rules and regulations and Township of Clinton ordinances and Co-owners shall be responsible for the collection and proper disposal of trash (or the Association's costs collecting and disposing of such trash) dispersed about the Common Elements, regardless of the reason. The Common Elements shall not be used for the drying or airing of clothing or other fabrics. In general, no activity shall be carried on nor condition maintained either in their Unit or upon the Common Elements that detracts from or spoils the Condominium appearance. No unsightly condition shall be maintained on or in any deck, patio, or porch, and only furniture and equipment consistent with ordinary deck, patio, or porch, use shall be permitted to remain on these areas during seasons when such areas are reasonably in use and shall not be on these areas during seasons when these areas are not reasonably in use. Estate sales may be permitted within the Condominium but only if in accordance with the Association's rules and regulations and, except for such estate sales, there shall be no garage, rummage or other sales within the Condominium and that are open to the public regardless of whether a permit has been issued by municipal agencies or otherwise. Garage doors shall be kept closed at all times except as may be reasonably necessary to gain access to or from the garage. All municipal ordinances pertaining to the use of the Common Elements shall be followed at all times.

Section 7. Obstruction of Common Elements. Except as otherwise expressly permitted in the Condominium Documents, the Common Elements, including, without limitation, roads, shall not be obstructed in any way nor shall they be used for purposes other than for which they are reasonably and obviously intended. Except as otherwise expressly permitted in the Condominium Documents, no bicycles, toys, baby carriages or other personal property may be left unattended on or about the Common Elements; provided, however, that furniture and equipment consistent with ordinary deck, patio, or porch use may be placed on decks, patios, or porches, as the case may be.

Section 8. Vehicles upon the Condominium.

A. Permitted Vehicles in General. Except as otherwise provided in this Section or in the Association's Rules and Regulations, only currently licensed automobiles, motorcycles (if not objectionable due to excessive noise or irresponsible operation), non-commercial pickup trucks, SUVs, and passenger vans not exceeding 21 feet in overall length, which are used as an occupant's primary

means of transportation and not for any commercial purposes, may be parked in the Condominium. Unless parked fully in a Unit garage with the door closed or except as otherwise provided in this Section, no house trailers, commercial vehicles (as defined in subsection C below), boat trailers, watercraft, boats, motor homes, camping vehicles, camping trailers, trailers, snowmobiles, snowmobile trailers, recreational vehicles, non-motorized vehicles, off-road vehicles or all-terrain vehicles shall be parked or stored in the Condominium.

B. Temporary Presence. The Board of Directors has the discretion to issue rules and regulations that provide for the temporary presence of the above enumerated recreational/leisure vehicles upon the Condominium for purposes such as loading and unloading. The Association shall not be responsible for any damages, costs, or other liability arising from any failure to approve the parking of or to designate a parking area for such vehicles.

C. Commercial Vehicles. Commercial vehicles shall not be parked in or about the Condominium (except as above provided) unless parked in an area specifically designated for such vehicles or trucks by the Board, or while making deliveries or pickups in the normal course of business. For purposes of this Section, commercial vehicles shall include vehicles or trucks with a curb weight of more than 10,000 pounds, overall length in excess of 21 feet, or with more than two axles, vehicles with commercial license plates, vehicles with any commercial markings or advertising appearing on the exterior, vehicles not designed or intended for personal transportation, or any vehicle either modified or equipped with attachments, equipment or implements of a commercial trade, including, but not limited to, ladder or material racks, snow blades, tanks, spreaders, storage bins or containers, vises, commercial towing equipment or similar items. For purposes of this Section, passenger vans, SUVs and pickup trucks, used for primary transportation and not for commercial purposes shall not be considered commercial vehicles provided they do not meet the definition of a commercial vehicle contained in this Section. The Association shall not be responsible for any damages, costs, or other liability arising from any failure to approve the parking of such vehicles or to designate an area for parking such vehicles.

D. Standing Vehicles, Repairs. Nonoperational vehicles or vehicles with expired license plates shall not be parked on the Condominium, other than inside a Co-owner's garage, without the Board's written approval. Nonemergency maintenance or repair of vehicles shall not be permitted on the Condominium without the Board's written approval.

E. Parking Restrictions. All occupants must park their permitted vehicles first in the Unit's garage and then on the Unit's Limited Common Element driveway. Notwithstanding the foregoing, the following special parking restrictions apply to Units 8, 13, 16, 19, 20, 25, 28, 33, 36, 85, 88, 93, 100, 105 and 108 (the "restricted Units"): no cars shall be parked in any of the driveways appurtenant to a restricted Unit except within the area of the driveway lying between the street and a line across the driveway parallel to and 30 feet from the street; further, the Co-owners of Units 19 and 20 may respectively park only within an area of the restricted drive which is one-half its width and which provides the most direct access to each such Unit. Except as otherwise approved by the Board in writing or as otherwise set forth in any Association rules and regulations, parking on the Condominium roads is prohibited between the hours of 2:00 a.m. and 7:00 a.m. No parking of any vehicles is permitted in designated fire lanes or in violation of duly promulgated rules and regulations of the Association.

F. Association Rights. Subject to Section 252k of the Michigan Vehicle Code (MCL §257.252k), the Board may cause vehicles parked or stored in violation of this Section, or of any applicable Association rules and regulations, to be stickered and towed from the Condominium, and the cost of such removal may be assessed to, and collected from, the Co-owner of the Unit responsible for the presence of the vehicle in the manner provided in Article II of these Amended and Restated Bylaws. In such cases, the Co-owner shall be responsible for costs incurred in having a towing company respond, even if the vehicle is moved and properly parked before the towing contractor arrives at the Condominium. The Board of Directors may promulgate reasonable rules and regulations governing the parking and use of vehicles in the Condominium.

Section 9. Prohibition of Dangerous Items upon the Condominium. Except as otherwise set forth in the Association's rules and regulations as are published from time to time or as otherwise approved by the Board in writing, no Co-owner shall use, or permit the use by an occupant, agent, employee, invitee, guest or member of their family, any drones, firearms, air rifles, pellet guns, BB guns, bows and arrows, fireworks, slingshots or other similar dangerous weapons, projectiles or devices anywhere on or about the Condominium, nor shall any Co-owner use or permit to be brought onto the Condominium any unusually volatile liquids or materials deemed to be extra hazardous to life, limb, or property.

Section 10. Signs. Except for a U.S. flag no larger than 3' x 5', no flags, notices, advertisements, pennants or signs, including "for sale" and "open house" signs, shall be displayed which are visible from the exterior of a Unit without written permission from the Association, unless the same are in complete conformance with the Association's rules and regulations.

Section 11. Rules and Regulations Consistent with Condominium Act. The Board may make and amend from time to time reasonable rules and regulations consistent with the Condominium Act, the Amended and Restated Consolidating Master Deed, and these Bylaws, concerning the use of the Common Elements or the rights and responsibilities of the Co-owners and the Association with respect to the Condominium or the manner of the Association's or Condominium's operation. The Association shall furnish to all Co-owners all such regulations and any amendments to the regulations and such regulations shall become effective as stated in such regulation. Any such regulation or amendment may be revoked at any time by the affirmative vote of more than fifty percent (50%) of all Co-owners in good standing.

Section 12. Association Access to Units and Common Elements. The Association or its duly authorized agents shall have access to each Unit and any Common Elements from time to time, during reasonable working hours, upon notice to the Co-owner, as may be necessary for the maintenance, repair or replacement of any of the Common Elements. The Association or its agents shall also have access to each Unit and the Common Elements at all times without notice as may be necessary to make emergency repairs to prevent damage to the Common Elements or to another Unit. Each Co-owner shall provide the Association means of access to their Unit and any Common Elements during all periods of absence and in the event the Co-owner fails to provide means of access, the Association may gain access in such manner as may be reasonable under the circumstances, including removing any obstructions or materials that restrict such access, and shall not be liable to such Co-owner for any damage to their Unit or any Common Elements caused in gaining such access, or for repairing, replacing or reinstalling any removed obstructions or materials in gaining such access. No Co-owner shall in any way restrict access to any

plumbing, water line, water line valves, water meters, sump pump, sprinkler system valves or any other element that must be accessible to service the Common Elements or any element which affects an Association responsibility in any way. Should access to any facilities of any sort be required, the Association may remove any coverings or attachments of any nature that restrict such access and will have no responsibility for repairing, replacing or reinstalling any materials, whether or not installation has been approved in accordance with the Condominium Documents, that are damaged in the course of gaining such access, nor shall the Association be responsible for monetary damages of any sort arising out of actions taken to gain necessary access.

Section 13. Landscaping and Decoration of Common Elements. No Co-owner shall perform any landscaping or plant any trees, shrubs or flowers or place any ornamental materials, including but not limited to statuary, bird feeders, exterior lighting, furniture, implements, rocks or boulders, fencing or other decorative items upon the General or Limited Common Elements unless the same is in total conformance with the Association's rules and regulations on landscaping as are published from time to time or is otherwise approved by the Board in writing. Any Co-owner landscaping that the Board approves shall be the Co-owner's responsibility to maintain unless the Board specifies otherwise in writing. If such Co-owner fails to adequately maintain such landscaping to the Association's satisfaction, the Association has the right to perform such maintenance and assess and collect from the Co-owner the cost in the manner provided in Article II of these Bylaws. The Co-owner shall also be liable for any damages to the Common Elements arising from the performance, planting or continued maintenance of such landscaping.

Section 14. Co-owner Maintenance of Unit and Common Elements.

A. Each Co-owner shall maintain their Unit and any Common Elements for which they have maintenance responsibility in a safe, clean and sanitary condition. All Units must have operational smoke detectors installed. Co-owners shall implement reasonable precautionary maintenance and winterization measures with respect to any vacant Unit as the Board of Directors from time to time shall require.

B. Each Co-owner shall use due care to avoid damaging any of the Common Elements, including, but not limited to, the telephone, water, gas, plumbing, electrical, cable TV or other utility conduits and systems and any other Common Elements in any Unit which serve or which may affect any other Unit. Each Co-owner shall be responsible for damages or costs to the Association resulting from damage to or misuse of the any of the Common Elements by them, or their family, guests, agents or invitees, or by casualties and occurrences, whether or not resulting from Co-owner negligence, involving items or Common Elements which are the responsibility of the Co-owner to maintain, repair and replace, unless such damages or costs are covered by primary insurance carried by the Association, in which case there shall be no such responsibility unless reimbursement to the Association is excluded by virtue of a deductible provision, in which case the responsible Co-owner shall bear the expense to the extent of the deductible amount. Any costs or damages to the Association, including actual attorneys' fees, may be assessed to and collected from the responsible Co-owner in the manner provided in Article II of these Amended and Restated Bylaws. Each Co-owner shall indemnify the Association against such damages and costs, including actual attorneys' fees, and all such costs or damages to the Association may be assessed to and collected from the responsible Co-owner in the manner provided in Article II.

C. Co-owners have the responsibility to report to the Association any Common Element which has been damaged or which is otherwise in need of maintenance, repair or replacement as soon as it is discovered.

Section 15. Application of Restrictions to the Association. None of the restrictions contained in this Article VI or elsewhere in the Condominium Documents shall apply to the Association's activities in furtherance of its powers and purposes set forth in the Condominium Documents or the Condominium Act.

Section 16. Cost of Enforcing Documents. All costs, damages, fines, expenses or actual attorneys' fees incurred or levied by the Association in enforcing the Condominium Documents against a Co-owner or their licensees or invitees, including without limitation the restrictions set forth in this Article VI, may be assessed to, secured by the statutory lien on the Unit and collected from the responsible Co-owner or Co-owners in the manner provided in Article II of these Amended and Restated Bylaws. This specifically includes actual costs and legal fees incurred by the Association in investigating and seeking legal advice concerning violations, and responding to and defending actions relating to violations in small claims court, or any other court of competent jurisdiction.

Section 17. Approvals Revocable. Any approval granted by the Board is a license. If a Co-owner is not in compliance with the conditions of any Board approval, the Board may revoke the approval upon thirty (30) days written notice.

ARTICLE VII MORTGAGES

Section 1. Notification of Mortgage. Any Co-owner who mortgages their Unit shall notify the Association of the name and address of the mortgagee, and the Association shall maintain such information in a book entitled "Mortgages of Units." The Association may, at the written request of a mortgagee of any such Unit, report any unpaid assessments due from the Co-owner of such Unit.

Section 2. Notification to Mortgagee of Insurance Company. Upon written request submitted to the Association, the Association shall notify a mortgagee appearing in the Mortgages of Units book of the name of each company insuring the Common Elements against fire and perils covered by extended coverage, and vandalism and malicious mischief and the amounts of such coverage.

Section 3. Notification to Mortgagee of Meetings. Upon written request submitted to the Association, any institutional holder of a first mortgage lien on any Unit shall be entitled to receive written notification of every Association meeting and to designate a representative to attend such meeting.

Section 4. Notification to Mortgagees and Guarantors. Upon written request submitted to the Association, any institutional holder of any mortgage or any guarantors of the mortgage covering any Unit shall be entitled to receive timely written notice of (i) any proposed action that requires the consent of a specified percentage of mortgagees, whether contained in the Amended and Restated Consolidating Master Deed or these Bylaws, (ii) any delinquency in the payment of assessments or other charges by a Co-owner that is not cured within sixty (60) days, and (iii) any lapse, cancellation or material modification of any insurance policy maintained by the Association.

**ARTICLE VIII
MEMBERSHIP AND VOTING**

Section 1. Association Membership. Each Co-owner is a member of the Association and no other person or entity is entitled to membership.

Section 2. Voting.

A. Voting Rights. Except as limited in these Bylaws, each Co-owner shall be entitled to one vote for each Unit owned, provided that the Co-owner is in good standing. As used throughout the Condominium Documents, "good standing" means a Co-owner (or Director, as the case may be) who is current in all financial obligations owing to the Association and who is not in default of the Condominium Documents. Voting shall be by number. In the case of any Unit owned jointly by more than one Co-owner, the voting rights associated with that Unit may be exercised only jointly as a single vote.

B. Evidence of Ownership for Voting Purposes. No Co-owner shall be entitled to vote at any Association meeting until they have presented evidence of ownership of a Unit to the Association by way of a recorded Deed, recorded Land Contract or recorded Memorandum of Land Contract. The vote of each Co-owner may be cast only by the individual representative designated by such Co-owner in the notice required in subsection C below or by a proxy given by such individual representative.

C. Designation of Voting Representative. Each Co-owner shall file a written notice with the Association designating the individual representative who shall vote at Association meetings and receive all notices and other communications from the Association on behalf of such Co-owner. The notice shall state the name and address of the individual representative designated, the number or numbers of the Unit or Units owned by the Co-owner, and the name and address of each person, firm, corporation, partnership, limited liability company, association, trust or other entity that is the Co-owner. The Co-owner shall sign and date such notice. The Co-owner may change the individual representative designated at any time by filing a new notice in the manner provided in this subsection. At any Association meeting the chairperson of the meeting may waive the filing of such written notice as a prerequisite to voting.

D. Voting Method. Votes may be cast in person, by proxy, in writing duly signed by the designated voting representative, or by any other means allowed by the voting procedures adopted by the Board of Directors for a given vote. The Board of Directors may permit the casting of votes by mail, fax, personal delivery, electronic transmission, or by other Board-approved means. Any proxies, written votes or other votes cast by permitted means must be filed with the Association's Secretary or the Association's management agent at or before the appointed time of the Association meeting or voting deadline if no meeting is held. As used in these Bylaws, "electronic transmission" means transmission by any method authorized by the person receiving such transmission and not directly involving the physical transmission of paper, which creates a record that the Association may retrieve and retain and that the Association may directly reproduce in paper through an automated process. Cumulative voting is not permitted.

E. Majority. Unless otherwise provided, any action that could be authorized at an Association meeting or by written vote shall be authorized by the vote of a simple majority of those Co-owners in good standing.

Section 3. Action without Meeting. Any action that may be taken at an Association meeting (except for electing or removing Directors) may be taken without a meeting by written vote or ballot of the Co-owners. Written votes or ballots shall be solicited in the same manner as provided in these Bylaws for the giving of notice of Association meetings. Such solicitations shall specify: (1) the proposed action; (2) that the Co-owner can vote for or against any such proposed action; (3) the percentage of approvals necessary to approve the action; and (4) the time by which written votes must be received to be counted. Approval by written vote or ballot shall be constituted by receipt, within the time specified in the written vote or ballot, of a number of approvals that equals or exceeds the number of votes that would be required for approval if the action were taken at a meeting.

ARTICLE IX MEETINGS

Section 1. Place of Meetings. Association meetings shall be held at any suitable place convenient to the Co-owners as the Board may designate. Association meetings shall be guided by Roberts Rules of Order or some other generally recognized manual of parliamentary procedure when not otherwise in conflict with the Articles of Incorporation, the Amended and Restated Consolidating Master Deed or the laws of the State of Michigan. Only Co-owners in good standing may speak at Association meetings or address the Board or Co-owners at any such meetings. Any person in violation of this provision or the rules of order governing the meeting may be removed from such meeting, without any liability to the Association or its Board of Directors.

Section 2. Quorum. The presence in person or by proxy of 35% of the Co-owners in good standing constitutes a quorum for holding an Association meeting. The written vote of any person furnished at or prior to any Association meeting at which meeting such person is not otherwise present in person or by proxy, or by such date as is established for voting in cases where no meeting is held, shall be counted in determining the presence of a quorum with respect to the question upon which the vote is cast. Any Co-owner who participates by remote communication in an Association meeting, as provided in Article IX, Section 6 below, shall also be counted in determining the necessary quorum.

Section 3. Annual Meetings. The Association shall hold its annual meeting in the month of Month each succeeding year at such date, time and place as the Board of Directors determines. The Board may change the date of the annual meeting in any given year, provided that at least one such meeting is held in each calendar year. Written notice of each annual meeting, as well as any change in the date of the annual meeting, shall be given to all Co-owners at least ten (10) days before the date for which the meeting is or was originally scheduled. At the annual meeting, there shall be elected by ballot or acclamation of the Co-owners a Board of Directors in accordance with the requirements of Article X of these Bylaws. The Co-owners may also transact at annual meetings such other Association business as may properly come before them.

Section 4. Special Meetings. The President shall call a special meeting of the Co-owners as directed by Board resolution. The President shall also call a special meeting upon a petition presented to the Association's Secretary that is signed by one third (1/3rd) of those Co-owners in good standing.

Notice of any special meeting shall state the time, place and purpose of such meeting. No business shall be transacted at a special meeting except as stated in the notice.

Section 5. Notice of Meetings. The Secretary or other Board authorized person shall serve each Co-owner a notice of each annual or special meeting, stating the purpose as well as the time and place where it is to be held, at least ten (10) days, but not more than sixty (60) days, prior to such meeting. The mailing, postage prepaid, of a notice to the representative of each Co-owner at the address shown in the notice required to be filed with the Association pursuant to Article VIII, Section 2C of these Bylaws or to the address of the Unit owned by the Co-owner shall be deemed notice served. In lieu of the foregoing, such notice may also be given by electronic transmission, or hand delivered to a Unit if the Unit address is designated as the voting representative's address, and/or the Co-owner is a resident of the Unit. Any Co-owner may, by written waiver of notice signed by such Co-owner, waive such notice, and such waiver when filed in the Association's records shall be deemed due notice.

Section 6. Remote Communication Attendance; Remote Communication Meetings. Co-owners may participate in Association meetings by a conference telephone or by other means of remote communication through which all persons participating in the meeting may hear each other, if the Board determines to permit such participation and (a) the means of remote communication permitted are included in the notice of the meeting or (b) if notice is waived or not required. All participants shall be advised of the means of remote communication in use and the names of the participants in the meeting shall be disclosed to all participants. Co-owners participating in a meeting by means of remote communication are considered present in person and may vote at such meeting if all of the following are met: (a) the Association implements reasonable measures to verify that each person considered present and permitted to vote at the meeting by means of remote communication is a Co-owner or proxy holder; (b) the Association implements reasonable measures to provide each Co-owner and proxy holder a reasonable opportunity to participate in the meeting and to vote on matters submitted to the Co-owners, including an opportunity to read or hear the proceedings of the meeting substantially concurrently with the proceedings; and (c) if any Co-owner or proxy holder votes or takes other action at the meeting by means of remote communication, the Association maintains a record of the vote or other action. A Co-owner may be present and vote at an adjourned Association meeting by means of remote communication if they were permitted to be present and vote by the means of remote communication in the original meetings notice given. The Board may hold an Association meeting conducted solely by means of remote communication.

Section 7. Adjournment for Lack of Quorum. If any meeting of Co-owners cannot be held because a quorum is not in attendance, the Co-owners who are present may adjourn the meeting to a time not less than forty-eight (48) hours from the time the original meeting was called.

Section 8. Minutes. The Association shall keep minutes or a similar record of the proceedings of all Association meetings and, when signed by the President or Secretary, shall be presumed truthfully to evidence the matters set forth therein. A recitation in the minutes of any such meeting that notice of the meeting was properly given shall be prima facie evidence that such notice was given.

**ARTICLE X
BOARD OF DIRECTORS**

Section 1. Qualification and Number of Directors. The Board of Directors shall govern the Association's affairs. All Directors must be Co-owners in good standing. Any Director who is delinquent in any financial obligation owed to the Association, including late fees, shall pay in full the amount due within sixty (60) days of the delinquency. During the period of delinquency, the Director is not permitted to vote on any delinquency matter of another Co-owner, including matters that may affect the Director's own Unit. If the Director does not comply within the delinquency cure period, and notwithstanding the provisions of Section 6 below, the Director shall be deemed removed from the Board of Directors for the remainder of the Director's term and the vacancy shall be filled in accordance with Section 5 below. The Board shall consist of seven (7) members. No two occupants of the same Unit may serve on the Board of Directors at the same time. Directors shall serve without compensation.

Section 2. Term of Directors. The respective terms of office for the Directors have been staggered based on election procedures previously adopted by the Association. In each year, either four or three Directors shall be elected for two (2) year terms depending on how many directorships expire that year. All Directors shall hold office until their successors have been elected and hold their first meeting.

Section 3. Powers and Duties. The Board of Directors has all powers and duties necessary for the administration of the Association's affairs and may do all acts and things as are not prohibited by the Condominium Documents or required to be exercised and done by the Co-owners. In addition to the foregoing general powers and duties imposed by these Bylaws, or any further powers and duties which may be imposed by law or the Articles of Incorporation, the Board of Directors has the following powers and duties:

A. **Management and Administration.** To manage and administer the affairs of and maintenance of the Condominium and the Common Elements, all to the extent set forth in the Condominium Documents.

B. **Collecting Assessments.** To collect assessments from the Co-owners and to use the proceeds for the Association's purposes.

C. **Insurance.** To carry insurance and collect and allocate the proceeds in the manner set forth in Article IV.

D. **Rebuild Improvements.** To rebuild improvements after casualty in the manner set forth in Article V.

E. **Contract and Employ Persons.** To contract for and employ persons, firms, corporations or other agents to assist in the management, operation, maintenance and administration of the Condominium.

F. **Real or Personal Property.** To acquire, maintain and improve, and to buy, operate, manage, sell, convey, assign, mortgage or lease any real or personal property (including any Unit and

any easements, rights-of-way and licenses) on the Association's behalf in furtherance of any Association purposes.

G. Borrow Money. To borrow money and issue evidences of indebtedness in furtherance of any and all of the purposes of the Association's business, and to secure the same by mortgage, pledge, or other lien on property owned by the Association; provided, however, that any such action shall also be approved by affirmative vote of more than 60% of all Co-owners in good standing.

H. Assign Right to Future Income. To assign its right to future income, including the right to receive Co-owner assessment payments.

I. Rules and Regulations. To make rules and regulations in accordance with Article VI, Section 11 of these Bylaws.

J. Committees. To establish such committees as it deems necessary, convenient or desirable and to appoint persons to such committees for implementing the administration of the Condominium and to delegate to such committees, or any specific Association Officers or Directors, any functions or responsibilities which are not by law or the Condominium Documents required to be performed by the Board.

K. Enforce Documents. To enforce the Condominium Documents.

L. Administrator. To do anything required of or permitted to the Association as administrator of the Condominium under the Condominium Documents.

M. General. In general, to enter any kind of activity, to make and perform any contract and to exercise all powers necessary, incidental or convenient to the administration, management, repair, replacement and operation of the Condominium and the Association.

Section 4. Professional Management. The Board of Directors may employ for the Association a professional management agent at reasonable compensation established by the Board to perform such duties and services as the Board shall authorize, including, but not limited to, the duties listed in this Article. The Board may delegate to such management agent any other duties or powers which are not by law or by the Condominium Documents required to be performed by or have the approval of the Co-owners. In no event shall the Board be authorized to enter into any contract with a professional management agent in which the maximum term is greater than three (3) years, or which is not terminable by the Association upon ninety (90) days' written notice to the other party.

Section 5. Vacancies. Vacancies in the Board of Directors caused by any reason other than the removal of a Director by Co-owner vote shall be filled by majority vote of the remaining Directors even though they may constitute less than a quorum. Each person so appointed shall be a Director until the end of the term of the Director who they replaced and a successor is elected at the Association's annual meeting.

Section 6. Removal of Directors. At any annual or special Association meeting duly called and held, any one or more of the Directors may be removed with or without cause by the affirmative

vote of more than fifty percent (50%) of all Co-owners in good standing, and a successor may then and there be elected to fill the vacancy created. The quorum requirement for filling any vacancy shall be the normal 35%. Any Director whose removal has been proposed by the Co-owners shall have an opportunity to be heard at the meeting.

Section 7. First Meeting of New Board. The first meeting of a newly elected Board shall be held within ten (10) days of election at such place and time as shall be fixed by the Directors at the meeting at which such Directors were elected. No notice shall be necessary to the newly elected Directors to legally constitute such meeting, provided a majority of the entire Board is present at such a meeting.

Section 8. Regular Meetings. Regular Board of Directors meetings may be held at such times and places as shall be determined from time to time by a majority of the Directors. At least two (2) such meetings shall be held during each fiscal year. Notice of regular Board meetings shall be given to each Director personally, or by mail, facsimile, telephone or electronic transmission at least 5 (five) days prior to the date of the meeting, unless waived by such Director.

Section 9. Special Meetings. Special meetings of the Board of Directors may be called by the president upon 3 (three) days' notice to each Director given personally, or by mail, facsimile, telephone or electronic transmission. The notice shall state the time, place and purpose of the meeting. Special meetings of the Board of Directors shall be called by the president, secretary or other appropriate officer in like manner and on like notice on the written request of two Directors.

Section 10. Waiver of Notice. Before or at any Board meeting, any Director may in writing or orally waive notice of such meeting and such waiver shall be deemed equivalent to the giving of such notice. A Director's attendance at a Board meeting shall be deemed that Director's waiver of notice. If all the Directors are present at any Board meeting, no notice shall be required and any business may be transacted at such meeting.

Section 11. Quorum and Voting. The presence of a majority of the Directors at a meeting shall constitute a quorum for the transaction of business, and the acts of the majority of the Directors present at a meeting at which there is a quorum shall be the acts of the Board of Directors. A Director will be considered present and may vote on matters before the Board by remote communication, electronically or by any other method giving the remainder of the Board sufficient notice of the absent Director's vote and position on any given matter. If at any Board meeting there be less than a quorum present, the majority of those present may adjourn the meeting from time to time. At any such adjourned meeting, any business that might have been transacted at the meeting as originally called may be transacted without further notice. If a Director joins in the action of a meeting by signing and concurring in the minutes of that meeting, the Director shall be considered present for purposes of determining a quorum.

Section 12. Action without Meeting. Any action permitted to be taken by the Board of Directors at a meeting of the Board shall be valid in the absence of a meeting if consented to in writing, including by electronic transmission, by a majority of the Board of Directors. Further, the presiding Association officer, in exceptional cases requiring immediate action, may poll all Directors by phone for a vote, and provided the action is consented to by the requisite number of Directors, such vote shall

constitute valid action by the Board. The results of any vote along with the issue voted upon pursuant to this Section shall be noted in the minutes of the next Board meeting to take place.

Section 13. Closing of Board of Director Meetings to Members; Privileged Minutes. The Board of Directors, in its discretion, may close a portion or all of any meeting of the Board of Directors to the Co-owners or may permit Co-owners to attend a portion or all of any meeting of the Board of Directors. Any Co-owner has the right to inspect, and make copies of, the minutes of the meetings of the Board of Directors; provided, however, that no Co-owner shall be entitled to review or copy any minutes of meetings of the Board of Directors to the extent that such minutes reference privileged communications between the Board of Directors and counsel for the Association, or any other matter to which a privilege against disclosure pertains under Michigan Statute, common law, the Michigan Rules of Evidence, or the Michigan Court Rules.

Section 14. Remote Communication Participation. Board members may participate in any meeting by means of conference telephone or other means of remote communication through which all persons participating in the meeting can communicate with the other participants. Participation in a meeting by such means constitutes presence in person at the meeting.

Section 15. Fidelity Bond/Crime/Employee Dishonesty Insurance. The Board of Directors shall obtain fidelity bond or equivalent employee dishonesty/crime coverage in the minimum amount of a sum equal to three months aggregate assessments on all Units plus reserve funds on hand. Such fidelity bond or equivalent employee dishonesty/crime insurance covering all officers, directors, and employees of the Association and all other persons, including any management agent, handling or responsible for any monies received by or payable to the Association (it being understood that if the management agent or others cannot be added to the Association's coverage, they shall be responsible for obtaining the same type and amount of coverage on their own before handling any Association funds). The premiums for the foregoing shall be expenses of administration.

ARTICLE XI OFFICERS

Section 1. Designation. The principal Association officers are a president, vice president, secretary and treasurer. The Directors may appoint such other officers as may be necessary. Any two offices except that of president and vice president may be held by one person. The President must be a member of the Board of Directors.

Section 2. Appointment. The Board of Directors shall appoint the Association's officers annually and all officers shall hold office at the Board's pleasure.

Section 3. Removal. The Board of Directors may remove any officer either with or without cause, and the successor to the removed officer may be elected at any regular Board meeting or at any special Board meeting called for such purpose.

Section 4. President. The president shall be the Association's chief executive officer and shall preside at all Association and Board meetings. The president has all the general powers and duties which are usually vested in the office of the president of a nonprofit corporation including, but not

limited to, the power to appoint committees from among the Co-owners from time to time in the president's reasonable discretion to assist in the conduct of the Association's affairs.

Section 5. Vice President. The vice president shall take the place of the president and perform the president's duties whenever the president is absent or unable to act. If neither the president nor the vice president can act, the Board of Directors shall appoint some other Board member to so do on an interim basis. The vice president shall also perform such other duties as shall from time to time be imposed by the Board of Directors.

Section 6. Secretary. The secretary shall keep the minutes of all Board and Association meetings, be responsible for maintaining a record of the minutes and of such books and other records as the Board of Directors may direct, and shall in general perform all duties incident to the office of the secretary.

Section 7. Treasurer. The treasurer is responsible for keeping full and accurate accounts of all receipts and disbursements in the Association's books. The treasurer shall also be responsible for depositing all money and other valuable Association papers, in the name of and to the Association's credit, in such depositories that the Board may designate from time to time.

ARTICLE XII FINANCES, BOOKS AND RECORDS

Section 1. Fiscal Year. The Association's fiscal year shall be an annual period commencing on such date as the Board may initially determine. The commencement date of the Association's fiscal year is subject to change by the Board of Directors for accounting reasons or other good cause.

Section 2. Banking; Investment of Funds. Association funds shall be deposited in such bank or other depository as the Board may designate and shall be withdrawn only upon the check or order of such officers, employees or agents as are designated by Board resolution from time to time. Association funds shall only be held in accounts that are fully insured or backed by the full faith and credit of the United States Government. The Association may only utilize depositories or instruments where there is no risk of principal loss for investment of its monies.

Section 3. Co-owner's Share of Funds. A Co-owner's share in the Association's funds and assets cannot be assigned, pledged or transferred in any manner except as a Unit appurtenance.

Section 4. Association Records and Books; Audit or Review.

A. Association Records and Books. The Association shall maintain current copies of the Condominium Documents. The Association shall also keep detailed books of account showing all expenditures and receipts of administration, which shall specify the maintenance and repair expenses of the Common Elements and any other expenses incurred by or on the Association's behalf and the Co-owners. The Association's books shall be maintained in accordance with Section 57 of the Condominium Act. The books, records, contracts, and financial statements concerning the administration and operation of the Condominium shall be open for inspection by the Co-owners and their mortgagees during reasonable working hours and at mutually convenient times. The Association shall prepare and distribute to each Co-owner at least one (1) time a year a financial statement, the contents of which shall

be defined by the Board and which may be distributed by electronic transmission, provided that any Co-owner may receive a written financial statement upon written request. Any institutional holder of a first mortgage lien on any Unit shall be entitled to receive a copy of such annual financial statement within ninety (90) days following the end of the Association's fiscal year if requested in writing.

B. Audit or Review. The Association shall have its books, records and financial statements independently audited or reviewed on an annual basis by a certified public accountant, as defined in Section 720 of the occupational code (MCL 339.720); provided, however, that the Association may opt out of such certified audit or review on an annual basis by an affirmative vote of a majority of the Co-owners. Any audit or review shall be performed in accordance with the statements on auditing standards or the statements on standards for accounting and review services, respectively, of the American Institute of Certified Public Accountants.

ARTICLE XIII INDEMNIFICATION

Section 1. Indemnification of Directors, Officers and Volunteers. The Association shall indemnify every Director, officer and volunteer of the Association against all expenses and liabilities, including reasonable attorney fees and amounts paid in settlement incurred by or imposed upon the Director, officer or volunteer in connection with any threatened, pending or completed action, suit or proceeding, whether civil, criminal, administrative or investigative and whether formal or informal, to which the Director, officer or volunteer may be a party or in which they may become by reason of their being or having been a Director, officer or volunteer of the Association, whether or not they are a Director, officer or volunteer at the time such expenses are incurred, so long as the person acted in good faith and in a manner that they reasonably believed to be in or not opposed to the Association's best interests and, with respect to any criminal action or proceeding, had reasonable cause to believe that their conduct was lawful; provided, however, that the Association shall not indemnify any such person with respect to any claim, issue, or matter as to which such person has been finally adjudged to be liable for gross negligence or misconduct in the performance of his duty to the Association unless and only to the extent that a court shall determine upon application that, despite the adjudication of liability but in view of all the circumstances of the case, such person is fairly and reasonably entitled to indemnification for such expenses as the court shall deem proper. The foregoing right of indemnification shall be in addition to and not exclusive of all other rights to which such Director or officer may be entitled. The Board of Directors shall notify all Co-owners of payment of any indemnification that it has approved at least ten (10) days before payment is made. The indemnification rights of this Article shall always be construed to be consistent with those contained in the Association's Articles of Incorporation.

Section 2. Directors' and Officers' Insurance. The Association shall provide liability insurance for every Director and every officer of the Association for the same purposes provided above in Section 1 and in such amounts as may reasonably insure against potential liability arising out of the performance of their respective duties. No Director or officer shall collect for the same expense or liability under Section 1 above and under this Section 2; however, to the extent that the liability insurance provided to a Director or officer is inadequate to pay any expenses or liabilities otherwise properly indemnifiable under the terms of this Article, a Director or officer shall be reimbursed or indemnified only for such excess amounts under Section 1 above or other applicable statutory indemnification.

ARTICLE XIV COMPLIANCE

Section 1. Compliance with Condominium Documents. The Association and all present or future Co-owners, tenants, future tenants, or any other persons acquiring an interest in or using the Condominium in any manner are subject to and shall comply with the Condominium Act and the Condominium Documents. If the Amended and Restated Consolidating Master Deed, these Bylaws, or Articles of Incorporation conflict with the provisions of any Statute, the Statute shall govern. If any provision of these Bylaws conflicts with any provision of the Amended and Restated Consolidating Master Deed, the Amended and Restated Consolidating Master Deed shall govern.

Section 2. Amendment. These Bylaws may be amended in accordance with the Condominium Act and the provisions of Article VIII of the Amended and Restated Consolidating Master Deed.

Section 3. Definitions. All terms used in these Amended and Restated Bylaws have the same meaning as set forth in the Amended and Restated Consolidating Master Deed, or as set forth in the Condominium Act.

ARTICLE XV REMEDIES FOR DEFAULT

Section 1. Default by a Co-owner. Any Co-owner default shall entitle the Association or another Co-owner or Co-owners to the following relief:

A. Remedies for Default by a Co-owner to Comply with the Documents. Failure to comply with the Condominium Documents shall be grounds for relief, which may include without intending to limit the same, an action to recover sums due for damages, injunctive relief, foreclosure of lien (if default in payment of assessment) or any combination of the foregoing, and such relief may be sought by the Association, or, if appropriate, by an aggrieved Co-owner or Co-owners.

B. Costs Recoverable from Co-owner. A Co-owner's, non-Co-owner occupant's or guest's failure to comply with the Condominium Documents shall entitle the Association to recover from such Co-owner or non-Co-owner resident or guest the pre-litigation costs and actual reasonable attorneys' fees incurred in obtaining their compliance with the Condominium Documents. In addition, in any proceeding arising because of an alleged default by any Co-owner, or in cases where the Association must defend an action brought by any Co-owner(s) or non-Co-owner residents or guests, and regardless if the claim is original or brought as a defense, a counterclaim, cross claim or otherwise, the Association, if successful, shall be entitled to recover from such Co-owner or non-Co-owner resident or guest pre-litigation costs, the costs of the proceeding and actual attorney's fees (not limited to statutory fees), incurred in defense of any claim or obtaining compliance or relief, but in no event shall any Co-owner be entitled to recover such attorney's fees or costs against the Association. The Association, if successful, shall also be entitled to recoup the costs and attorneys' fees incurred in defending any claim, counterclaim or other matter.

Section 2. Association's Right to Abate. The violation of the Condominium Documents shall give the Association or its duly authorized agents the right, in addition to the rights set forth above, to

enter upon the Common Elements or into any Unit where reasonably necessary, and summarily remove and abate, at the expense of the Co-owner in violation, any structure, thing or condition existing or maintained contrary to the Condominium Documents. The Association has no liability to any Co-owner arising out of its exercise of its removal and abatement power.

Section 3. Assessment of Fines. The violation of the Condominium Documents by any Co-owner or their licensees or invitees shall be grounds for assessment by the Association, acting through its Board of Directors, of monetary fines for such violations in accordance with Article XVI of these Bylaws.

Section 4. Failure to Enforce Rights. The failure of the Association or of any Co-owner to enforce any right, provision, covenant or condition that may be granted by the Condominium Documents shall not constitute a waiver of the right of the Association or of any such Co-owner to enforce such right, provisions, covenant or condition in the future.

Section 5. Cumulative Rights. All rights, remedies and privileges granted to the Association or any Co-owner or Co-owners pursuant to any terms, provisions, covenants or conditions of the Condominium Documents shall be deemed to be cumulative and the exercise of any one or more shall not be deemed to constitute an election of remedies, nor shall it preclude the party thus exercising the same from exercising such other and additional rights, remedies or privileges as may be available to such party at law or in equity.

Section 6. Rights of Co-owners. A Co-owner may maintain an action against the Association to compel enforcement of the Condominium Documents, and may maintain an action for injunctive relief or damages against any other Co-owner for noncompliance with the Condominium Documents. Even if successful, Co-owners may not recover attorneys' fees from the Association, but may recover such fees from another Co-owner if successful in obtaining compliance with the Condominium Documents.

ARTICLE XVI FINES

Section 1. General. The violation by any Co-owner, occupant or guest of the Condominium Documents including any duly adopted rules and regulations shall be grounds for assessment by the Association, acting through its duly constituted Board of Directors, of monetary fines against the involved Co-owner. Such Co-owner shall be deemed responsible for such violations whether they occur as a result of their personal actions or the actions of their family, guests, tenants or any other person admitted through such Co-owner to the Condominium.

Section 2. Procedures. Prior to imposing any fine, the Board will adhere to the following procedures:

A. Notice. Notice of the violation, including the Condominium Document provision violated, together with a description of the factual nature of the alleged offense set forth with such reasonable specificity as will place the Co-owner on notice as to the violation, shall be sent by first class mail, postage prepaid, electronic transmission, or personally delivered to the representative of such Co-

owner at the address as shown in the notice required to be filed with the Association pursuant to Article VIII, Section 2C of these Bylaws.

B. Hearing and Decision. The offending Co-owner shall be provided a scheduled hearing before the Board at which the Co-owner may offer evidence in defense of the alleged violation. Except as otherwise determined by the Board, the hearing before the Board may be at its next scheduled meeting, but in no event shall the Co-owner be required to appear less than 7 days from the date of the notice. Upon appearance by the Co-owner before the Board and presentation of evidence of defense, or in the event the Co-owner fails to appear at the scheduled hearing, the Board shall, by majority vote of a quorum of the Board, decide whether a violation has occurred. The Board's decision is final.

Section 3. Fines. Upon violation of the Condominium Documents and upon the decision of the Board as recited above, the following fines may be levied:

FIRST VIOLATION	No fine will be levied unless the Board determines that the nature of the violation is such as to be best deterred if a fine is imposed for a first violation
SECOND VIOLATION	\$25.00 Fine
THIRD VIOLATION	\$50.00 Fine
FOURTH VIOLATION AND ALL SUBSEQUENT VIOLATIONS	\$100.00 Fine

The Board of Directors may make changes in fine amounts or adopt alternative fines pursuant to Article VI, Section 11 of these Bylaws and without the necessity of amending these Bylaws. For purposes of this Section, the number of the violation (i.e. first, second etc.) is determined with respect to the number of times that a Co-owner violates the same provision of the Condominium Documents, as long as that Co-owner may be an owner of a Unit or occupant of the Condominium, and is not based upon time or violations of entirely different provisions. In the case of continuing violations, a new violation will be deemed to occur each successive week during which a violation continues or in such intervals as may be set forth in the Association's rules and regulations; however, no hearings other than the first hearing shall be required for successive violations if a violation has been found to exist. Nothing in this Article shall be construed as to prevent the Association from pursuing any other remedy under the Condominium Documents or the Condominium Act for such violations, or from combining a fine with any other remedy or requirement to redress any violation.

Section 4. Collection of Fines. The fines levied pursuant to this Article shall be assessed against the Co-owner and shall be immediately due and payable. Failure to pay the fine will subject the Co-owner to all liabilities set forth in the Condominium Documents including, without limitations, those described in Article II and Article XV of these Bylaws.

**ARTICLE XVII
SEVERABILITY**

If any of the terms, provisions, or covenants of these Bylaws or the Condominium Documents are held to be partially or wholly invalid or unenforceable for any reason whatsoever, such holding shall not affect, alter, modify or impair in any manner whatsoever any of the other terms, provisions or covenants of such documents or the remaining portions of any terms, provisions or covenants which are held to be partially invalid or unenforceable.

**CONDOMINIUM SUBDIVISION PLAN
MORAVIAN MEADOWS**

MACOMB COUNTY CONDOMINIUM
SUBDIVISION PLAN No 208
EXHIBIT B TO THE CONSOLIDATING MASTER DEED OF
MORAVIAN MEADOWS
CLINTON TOWNSHIP,
MACOMB COUNTY, MICHIGAN.

DEVELOPER
KARAM BROTHERS INC.
A MICHIGAN CORPORATION
15620 15 MILE ROAD
FRASER, MICHIGAN
48026

SURVEYOR
ROBERT SHANAYDA
REGISTERED LAND SURVEYOR
37014 KELLY ROAD
MT. CLEMENS, MICHIGAN
48043


NOTE- UNIT NUMBERS 43,47,164,167,191,
194,203,227 ARE NOT USED IN
THIS CONDOMINIUM PROJECT

ONLY AS GOOD AS THE ORIGINAL

UNIT AREA


1. FILE DESCRIPTION.
2. SURVEY PLAN.
3. SITE PLAN, INCLUDING 1 THRU 14, 16 THRU 30.
4. SITE PLAN, INCLUDING 31, 32, 33, 34 THRU 42.
5. UTILITY PLAN, INCLUDING 1 THRU 14, 16 THRU 30.
6. UTILITY PLAN, INCLUDING 31, 32, 33, 34 THRU 42.
7. BLDG. 1, BASEMENT AND FIRST FLOOR PLAN, UNITS 1, 2, 3, 4.
8. BLDG. 1, 5, FIRST FLOOR PLAN, UNITS 5 THRU 12.
9. BLDG. 1, 5, FIRST FLOOR PLAN, UNITS 13 THRU 20.
10. BLDG. 4, 20, FIRST FLOOR PLAN, UNITS 21 THRU 24, 157 THRU 160.
11. BLDG. 7, 4, 20, 21, 41, BASEMENT AND FIRST FLOOR PLAN, UNITS 25 THRU 30, 140 THRU 143, 161 THRU 164.
12. BLDG. 16, BASEMENT AND FIRST FLOOR PLAN, UNITS 37, 38, 39, 40.
13. BLDG. 16, BASEMENT AND FIRST FLOOR PLAN, UNITS 41, 42, 44.
14. BLDG. 16, BASEMENT AND FIRST FLOOR PLAN, UNITS 43, 44, 46.
15. BLDG. 17, BASEMENT AND FIRST FLOOR PLAN, UNITS 48 THRU 52.
16. BLDG. 14, 21, 22, BASEMENT, FIRST FLOOR PLAN, 53 THRU 62, 165 THRU 172.
17. BLDG. 16, 20, 21, BASEMENT AND FIRST FL. PLAN, UNITS 63 THRU 64, 153 THRU 154, 229 THRU 234.
18. BLDG. 17, BASEMENT AND FIRST FLOOR PLAN, UNITS 65 THRU 68.
19. BLDG. 16, BASEMENT AND FIRST FLOOR PLAN, UNITS 69 THRU 72.
20. BLDG. 16, BASEMENT AND FIRST FLOOR PLAN, UNITS 73 THRU 76.
21. BLDG. 20, BASEMENT AND FIRST FLOOR PLAN, UNITS 77 THRU 80.
22. BLDG. 21, BASEMENT AND FIRST FLOOR PLAN, UNITS 81 THRU 84.
23. BLDG. 22, BASEMENT AND FIRST FLOOR PLAN, UNITS 85 THRU 88.
24. BLDG. 23, 24, FIRST FLOOR PLAN, UNITS 89 THRU 92.
25. BLDG. 25, 26, FIRST FLOOR PLAN, UNITS 93 THRU 104.
26. BLDG. 27, BASEMENT AND FIRST FLOOR PLAN, UNITS 105 THRU 108.
27. BLDG. 28, BASEMENT AND FIRST FLOOR PLAN, UNITS 109 THRU 112.

28. BLDG. 29, BASEMENT AND FIRST FLOOR PLAN, UNITS 113 THRU 116.
29. BLDG. 30, BASEMENT AND FIRST FLOOR PLAN, UNITS 117 THRU 120.
30. BLDG. 31, 32, FIRST FLOOR PLAN, UNITS 121 THRU 124.
31. BLDG. 33, 34, 35, FIRST FLOOR PLAN, UNITS 125 THRU 128, 165 THRU 168.
32. BLDG. 36, BASEMENT AND FIRST FLOOR PLAN, UNITS 149 THRU 152.
33. BLDG. 40, 41, 42, BASEMENT AND FIRST FLOOR PLAN, UNITS 153 THRU 162, 177 THRU 180, 225 THRU 232.
34. BLDG. 41, BASEMENT AND FIRST FLOOR PLAN, UNITS 163, 164, 165.
35. BLDG. 42, BASEMENT AND FIRST FLOOR PLAN, UNITS 166, 168, 169.
36. BLDG. 44, BASEMENT AND FIRST FLOOR PLAN, UNITS 170 THRU 176.
37. BLDG. 46, BASEMENT AND FIRST FLOOR PLAN, UNITS 181 THRU 184.
38. BLDG. 48, 49, BASEMENT AND FIRST FLOOR PLAN, UNITS 185, 186, 187, 223, 224, 225.
39. BLDG. 48, BASEMENT AND FIRST FLOOR PLAN, UNITS 188, 189, 190.
40. BLDG. 50, BASEMENT AND FIRST FLOOR PLAN, UNITS 191 THRU 200.
41. BLDG. 51, BASEMENT AND FIRST FLOOR PLAN, UNITS 201, 202, 203.
42. BLDG. 52, 53, FIRST FLOOR PLAN, UNITS 204 THRU 212.
43. BLDG. 54, FIRST FLOOR PLAN, UNITS 213 THRU 220.
44. BLDG. 56, 57, FIRST FLOOR PLAN, UNITS 243 THRU 248.
45. BLDG. 57, 62, FIRST FLOOR PLAN, UNITS 249 THRU 248.
46. BLDG. 1 THRU 62, CHECK SECTIONS, FIRST FLOOR ELEVATIONS, AND UNIT AREAS FOR PORCHES, DECKS, AND EXCLUDED PORCHES.
47. BLDG. 54, BASEMENT AND FIRST FLOOR PLAN, UNITS 213, 214, 215, 216.


AS BUILT AUG 6 1990
 RUC

MORAVIAN MEADOWS (SEE THE PREPARED)
LAND IN THE TOWNSHIP OF CLINTON, MACOMB COUNTY, MICHIGAN,
DESCRIBED AS:
PART OF LOTS 2 THROUGH 6, BOTH INCLUDING, "MORAVIAN DRIVE FARM"
A SUBDIVISION OF PART OF FRAGMENTAL SECTIONS 16 AND 21 AND PART OF
PRIVATE CLAIM 137, TOWN 2 NORTH, RANGE 13 EAST, CLINTON TOWNSHIP,
MACOMB COUNTY, MICHIGAN, AS REFERRED TO LINES 28-34, PAGE 10 AND BEING
MORE PARTICULARLY DESCRIBED AS FOLLOWS:
BEGINNING AT THE INTERSECTION OF THE NEARED LINE ALONG
MORAVIAN DRIVE AND THE WICKERLY LINE OF LOT 2 AND EXTENDING LINE OF
ST. LEONARD DRIVE, AS REFERRED TO LINES 37, PAGES 27 AND 28; THENCE
NORTH 41 DEGREES 30 MINUTES 40 SECONDS WEST 304.00 FEET ALONG SAID
LINE; THENCE SOUTH 44 DEGREES 30 MINUTES EAST 324.00 FEET; THENCE
NORTH 52 DEGREES 30 MINUTES WEST 409.37 FEET; THENCE SOUTH 44 DEGREES
30 MINUTES WEST 147.00 FEET; THENCE NORTH 58 DEGREES 25 MINUTES
WEST 440.00 FEET TO A POINT ON THE SOUTHWEST CORNER-OF-LOT 2
MORAVIAN DRIVE (440.00 FEET WIDE); THENCE NORTH-64 DEGREES 30 MINUTES
EAST 121.50 FEET ALONG THE SOUTHWEST CORNER-OF-LOT 2; THENCE
NORTH; THENCE SOUTH 32 DEGREES 30 MINUTES EAST 306.41 FEET; THENCE
NORTH 64 DEGREES 30 MINUTES EAST 104.00 FEET TO A POINT ON THE LINE
COMMON TO LOTS 3 AND 4 OF SAID "MORAVIAN DRIVE FARM"; THENCE SOUTH
32 DEGREES 30 MINUTES EAST 176.00 FEET; THENCE NORTH 32 DEGREES
30 MINUTES WEST 84.00 FEET TO A POINT ON THE SOUTHWEST CORNER-OF-LOT
LINE OF SAID MORAVIAN DRIVE (400.00 FEET WIDE); THENCE NORTH 32 DEGREES
30 MINUTES EAST 60.00 FEET ALONG THE WEST-SIDE OF MORAVIAN DRIVE
(400.00 FEET WIDE); THENCE SOUTH 32 DEGREES 30 MINUTES EAST 213.84 FEET;
THENCE NORTH 32 DEGREES 30 MINUTES WEST 13.84 FEET ALONG THE SAID LINE COMMON
TO LOTS 8 AND 9 OF SAID "MORAVIAN DRIVE FARM"; THENCE
NORTH 32 DEGREES 30 MINUTES WEST 13.84 FEET ALONG THE SAID LINE COMMON
TO LOTS 8 AND 9; THENCE NORTH 32 DEGREES 30 MINUTES EAST 411.22 FEET
TO A POINT ON THE LINE COMMON TO LOTS 8 AND 9 OF SAID "MORAVIAN DRIVE
FARM"; THENCE SOUTH 32 DEGREES 30 MINUTES EAST 428.30 FEET ALONG THE
SAID LINE COMMON TO LOTS 8 AND 9 TO A POINT ON THE NEARED LINE OF SAID
MORAVIAN DRIVE, THENCE ALONG SAID NEARED LINE OF THE MORAVIAN DRIVE
THE FOLLOWING COURSES AND DISTANCES: NORTH 60 DEGREES 30 MINUTES WEST
146.40 FEET SOUTH 13 DEGREES 47 MINUTES EAST 210.85 FEET; SOUTH 60 DEGREES
30 MINUTES EAST 304.75 FEET; SOUTH 60 DEGREES 30 MINUTES EAST 408.00 FEET;
SOUTH 48 DEGREES 30 MINUTES WEST 392.40 FEET; SOUTH 22 DEGREES 30 MINUTES
WEST 167.40 FEET; WESTWARD; SOUTH 70 DEGREES 13 MINUTES WEST 621.40 FEET
MEASURED SOUTH 70 DEGREES 13 MINUTES WEST 621.11 FEET TO THE
LINES EXTENDED TO THE CENTERLINE OF THE MORAVIAN DRIVE
SUBJECT TO ANY AND ALL EASEMENTS OF RECORD.

188-061008707

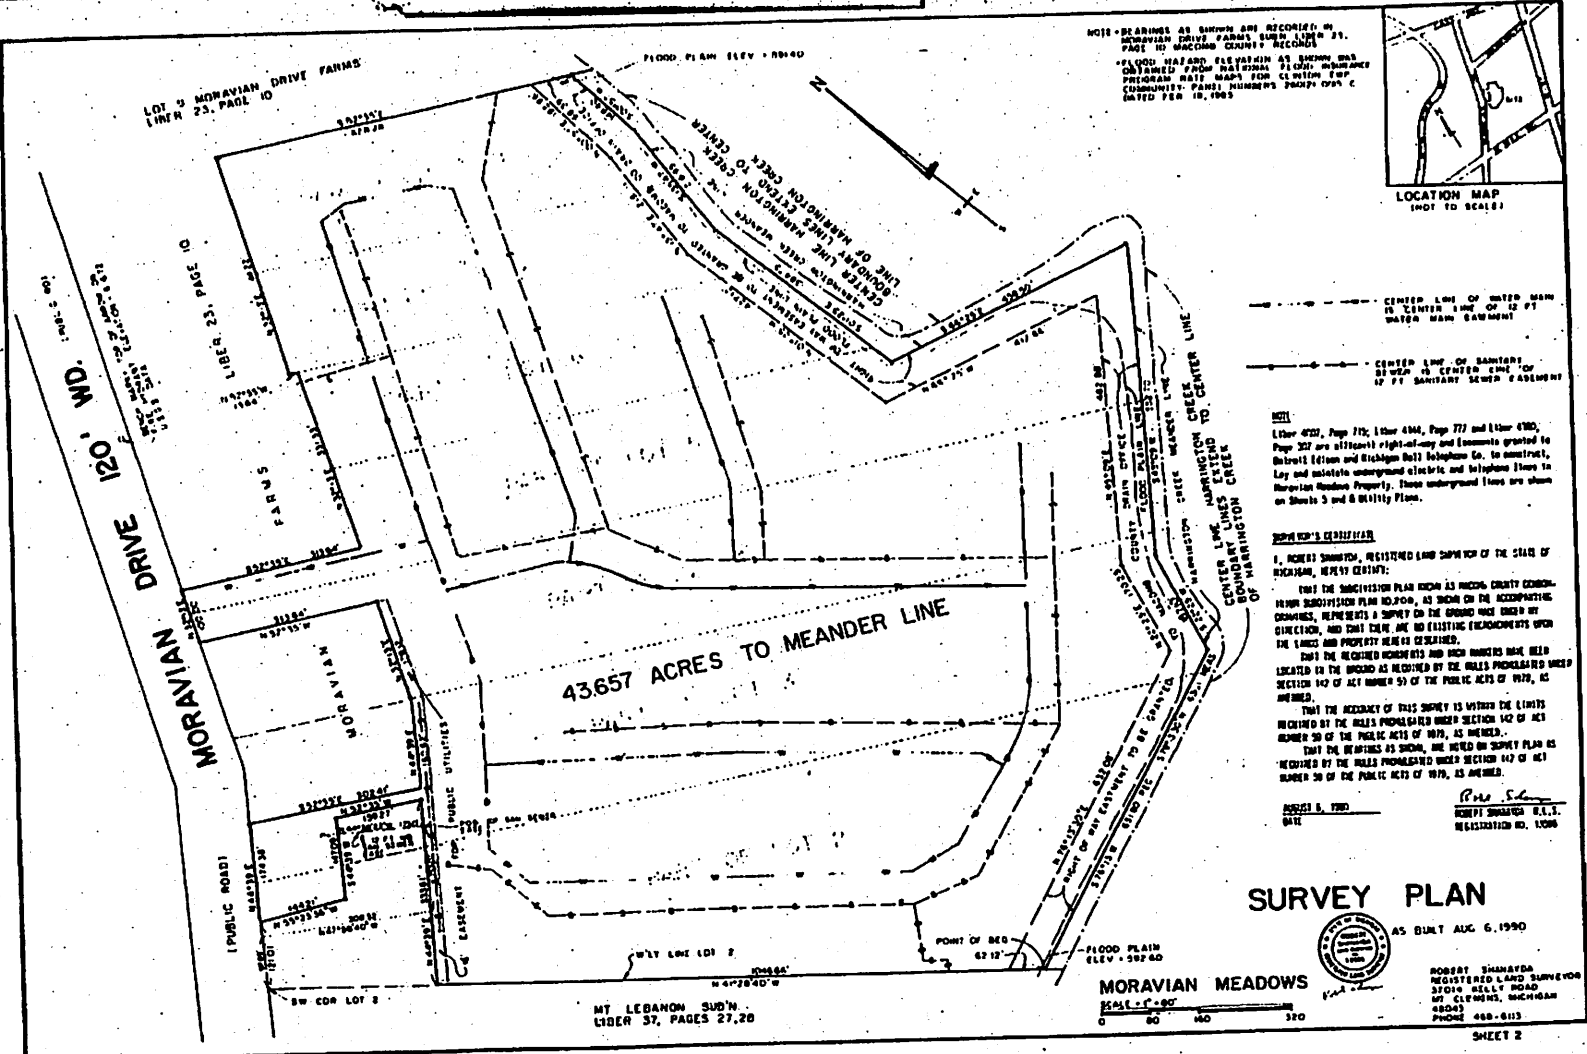

NOTE - BEARINGS AS SHOWN ARE RECORDED IN MORAVIAN DRIVE FARMS SUBD. LIBER 23, PAGE 10. PAGE 10, MACOMB COUNTY RECORDS. PLANS 142 AND 143, PARTAIN AS SHOWN WAS OBTAINED FROM NATIONAL FIRE INSURANCE PROGRAM BILLS MAPS FOR CLEVELAND CO. COMPILED BY FRED HUNTER'S PHOTOGRAPHY CO. DATED FEB. 18, 1965.

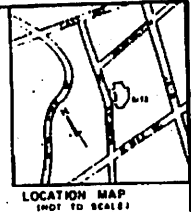

--- CENTER LINE OF WOODS CREEK TO CENTER LINE OF 12 FT WATER MAIN EASEMENT
 --- CENTER LINE OF SANITARY SEWER TO CENTER LINE OF 12 FT SANITARY SEWER EASEMENT

NOTE:
 LIBER 4722, Page 772; LIBER 4844, Page 777 and LIBER 4780, Page 327 are affidavits right-of-way and easements granted by Detroit Edison and Michigan Bell Telephone Co. to applicant. Lay and locate underground electric and telephone lines in Moravian Meadows Property. These underground lines are shown on Sheets 3 and 4 Utility Plans.

STATE OF MICHIGAN
 I, ROBERT SHANAYDA, REGISTERED LAND SURVEYOR OF THE STATE OF MICHIGAN, HEREBY CERTIFY:
 THAT THE SUBDIVISION PLAN HEREIN AS RECORD COUNTY CORRECTION NUMBER SUBDIVISION PLAN NO. 2040, AS SHOWN ON THE ACCOMPANYING DRAWINGS, REPRESENTS A SURVEY OF THE ABOVE NAMED TRACT OF LAND, AND THAT THERE ARE NO EXISTING ENCUMBRANCES UPON THE LANDS AND PROPERTY HEREIN DESCRIBED.
 THAT THE RECORDED ENCUMBRANCES AND EASEMENTS HAVE BEEN LOCATED TO THE SURVEY AS REQUIRED BY THE RULES PROMULGATED UNDER SECTION 142 OF ACT NUMBER 53 OF THE PUBLIC ACTS OF 1979, AS AMENDED.
 THAT THE ACCURACY OF THIS SURVEY IS WITHIN THE LIMITS REQUIRED BY THE RULES PROMULGATED UNDER SECTION 142 OF ACT NUMBER 53 OF THE PUBLIC ACTS OF 1979, AS AMENDED.
 THAT THE RULES AS SHOWN, ARE RULES ON SURVEY PLAN AS REQUIRED BY THE RULES PROMULGATED UNDER SECTION 142 OF ACT NUMBER 53 OF THE PUBLIC ACTS OF 1979, AS AMENDED.

ROBERT SHANAYDA
 DATE: _____
 REGISTERED LAND SURVEYOR, R.L.S.
 REGISTRATION NO. 11006

SURVEY PLAN



AS DULY AUC. 6, 1990

ROBERT SHANAYDA
 REGISTERED LAND SURVEYOR
 3701N. HELL F. ROAD
 44043
 PHONE 448-6113


MORAVIAN MEADOWS

SCALE = 1" = 80'
 0 80 160 320

MT LEBANON SUBD.
 LIBER 37, PAGES 27, 28

LIBER 061003708

SHEET 2

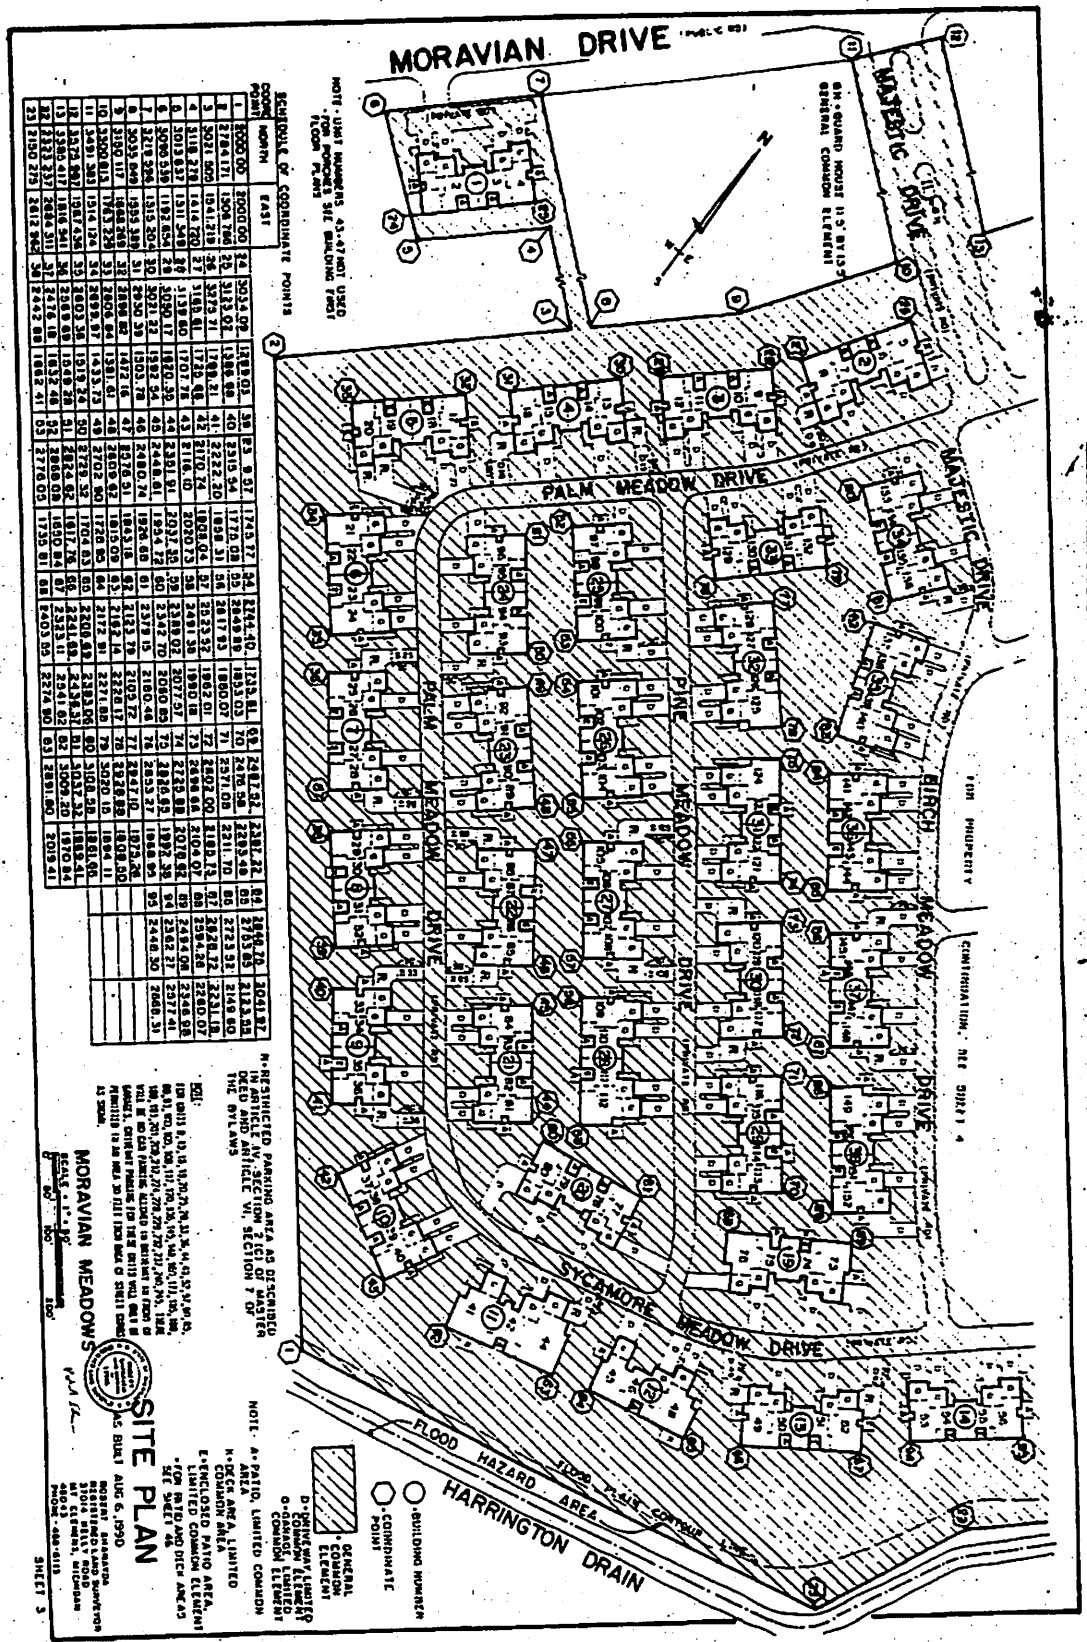

NOTE: UNIT NUMBERS 43-47 NOT USED FROM PREVIOUS SITE BUILDING FOOT ROOM PLANS

LEGEND OF COORDINATE POINTS

COORDINATE POINT	EAST	NORTH
RESTRICTED PARKING AREA AS DESCRIBED IN SECTION 2 OF MASTER DEED AND ARTICLE VI, SECTION 7 OF THE BYLAWS

NOTE: A- PAVED LIMITED COMMON AREA
 B- COMMON AREA, LIMITED
 C- UNPAVED COMMON ELEMENTS
 D- DRIVEWAY, LIMITED COMMON ELEMENTS
 E- COMMON ELEMENTS
 F- COMMON ELEMENTS
 G- COMMON ELEMENTS
SITE PLAN
 AUG 6, 1990
 MORAVIAN MEADOWS

LIBRARY 061000709

012300190

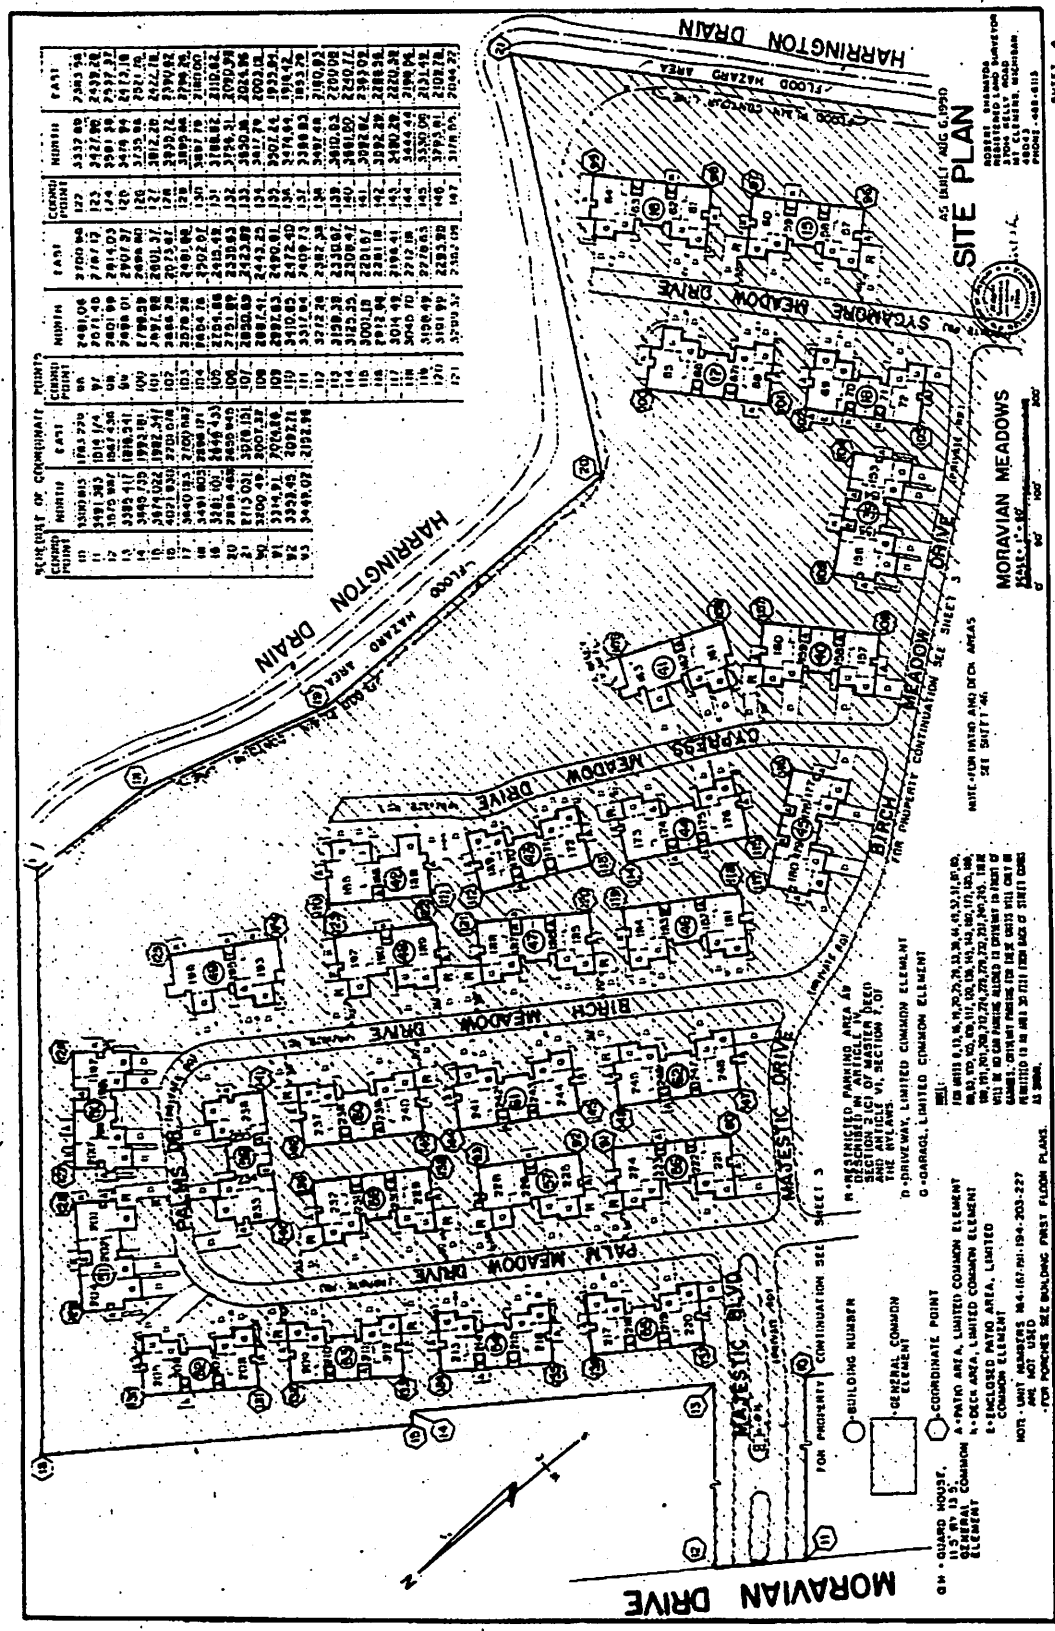


SHEET 4

SITE PLAN

AS BUILT - AUG 6, 1990

MORAVIAN MEADOWS
 PLAT 1-3-82
 100' 100' 100' 100'


WHITE FURNITURE AND DECK AREAS
 SET SHEET 4A

FOR MORE INFORMATION SEE SHEET 3
 FOR PROPERTY CONTINUATION SEE SHEET 3
 FOR PROPERTY CONTINUATION SEE SHEET 3

RESERVED PARKING AREA AS
 SECTION 2.1(C) OF MASTER DEED
 AND ARTICLE VI, SECTION 7.01
 OF SUBDIVISION LIMITED COMMON ELEMENT
 DEED
 G - GARAGE, LIMITED COMMON ELEMENT
 H - GENERAL COMMON ELEMENT
 I - COORDINATE POINT
 J - PATIO AREA, LIMITED COMMON ELEMENT
 K - DECK AREA, LIMITED COMMON ELEMENT
 L - ENCLOSED PATIO AREA, LIMITED
 COMMON ELEMENT
 M - UNIT ASSUMES 184-187-191-194-203-227
 NOT - UNIT ASSUMES 184-187-191-194-203-227
 FOR MORE INFORMATION SEE BUILDING FIRST FLOOR PLANS.


061003711

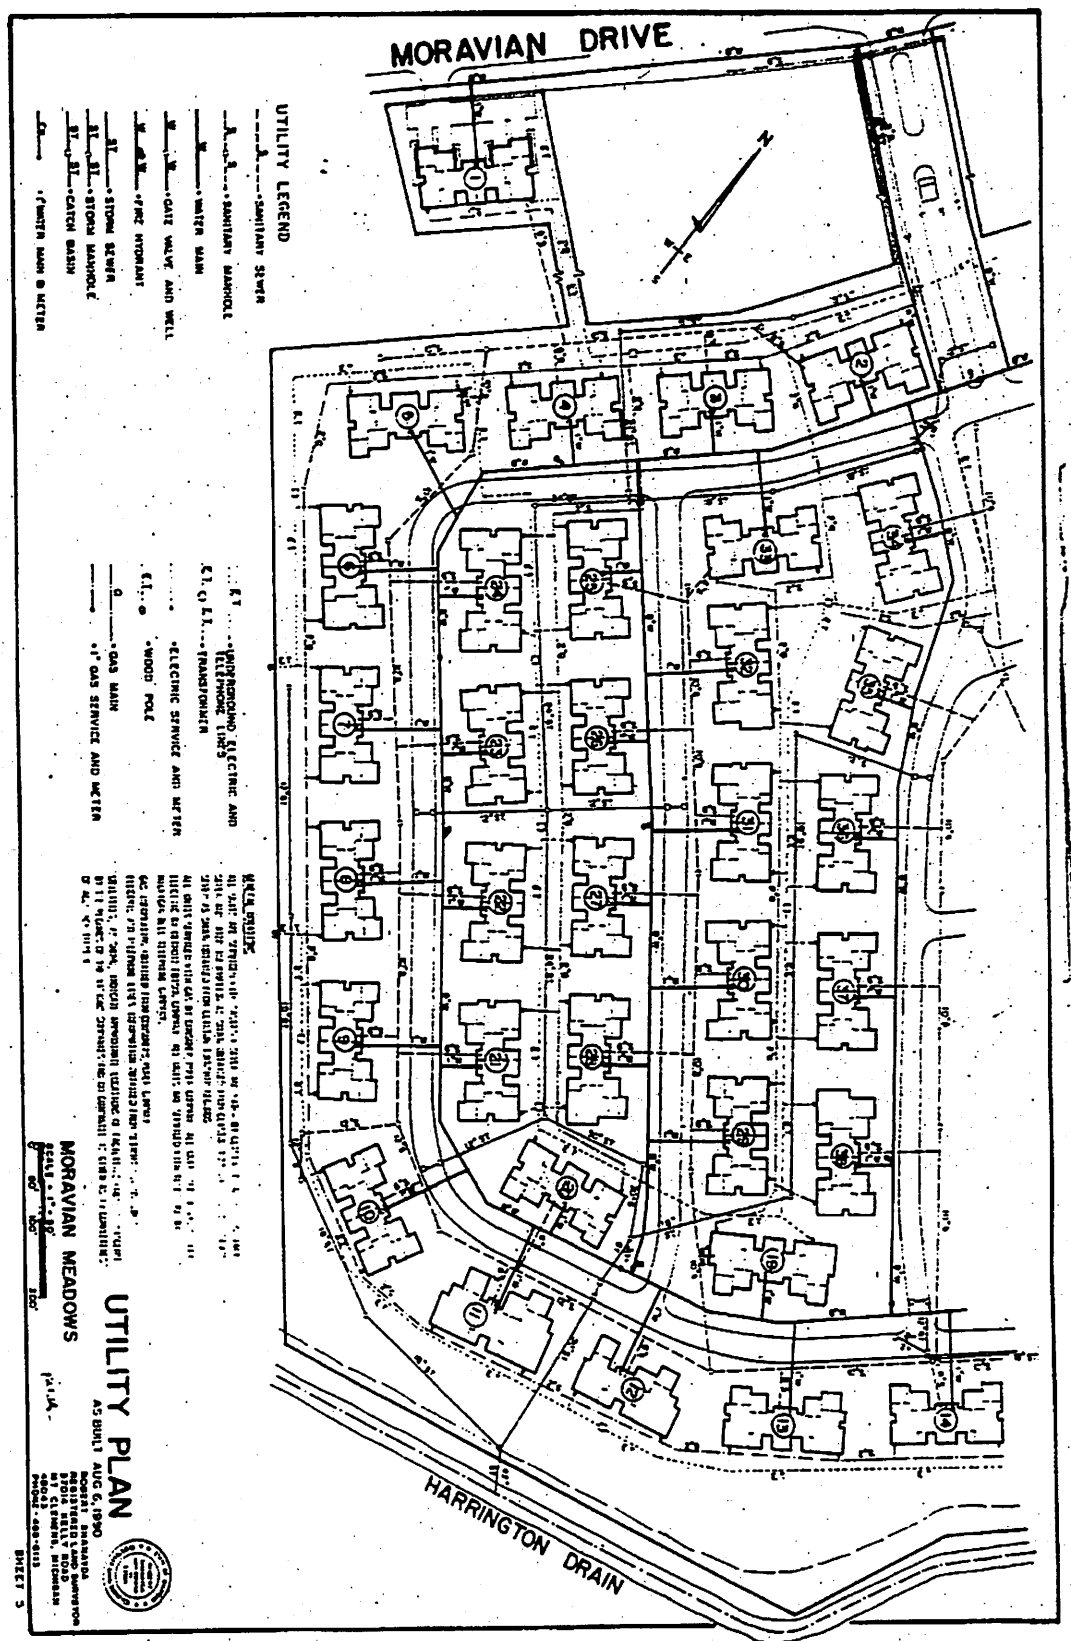

UTILITY LEGEND

- SANITARY SEWER
 - SANITARY MANHOLE
 - WATER MAIN
 - GAS WATER MAIN WELL
 - FIRE HYDRANT
 - STORM SEWER
 - CATCH BASIN
 - WATER MAIN METER
-
- APPROXIMATE ELECTRIC AND TELEPHONE LINES
 - TRANSFORMER
 - ELECTRIC SERVICE AND METER
 - WOOD POLE
 - GAS MAIN
 - GAS SERVICE AND METER

NOTE



UTILITY PLAN


MORAVIAN MEADOWS

AS BUILT AUG 6, 1990




21200190

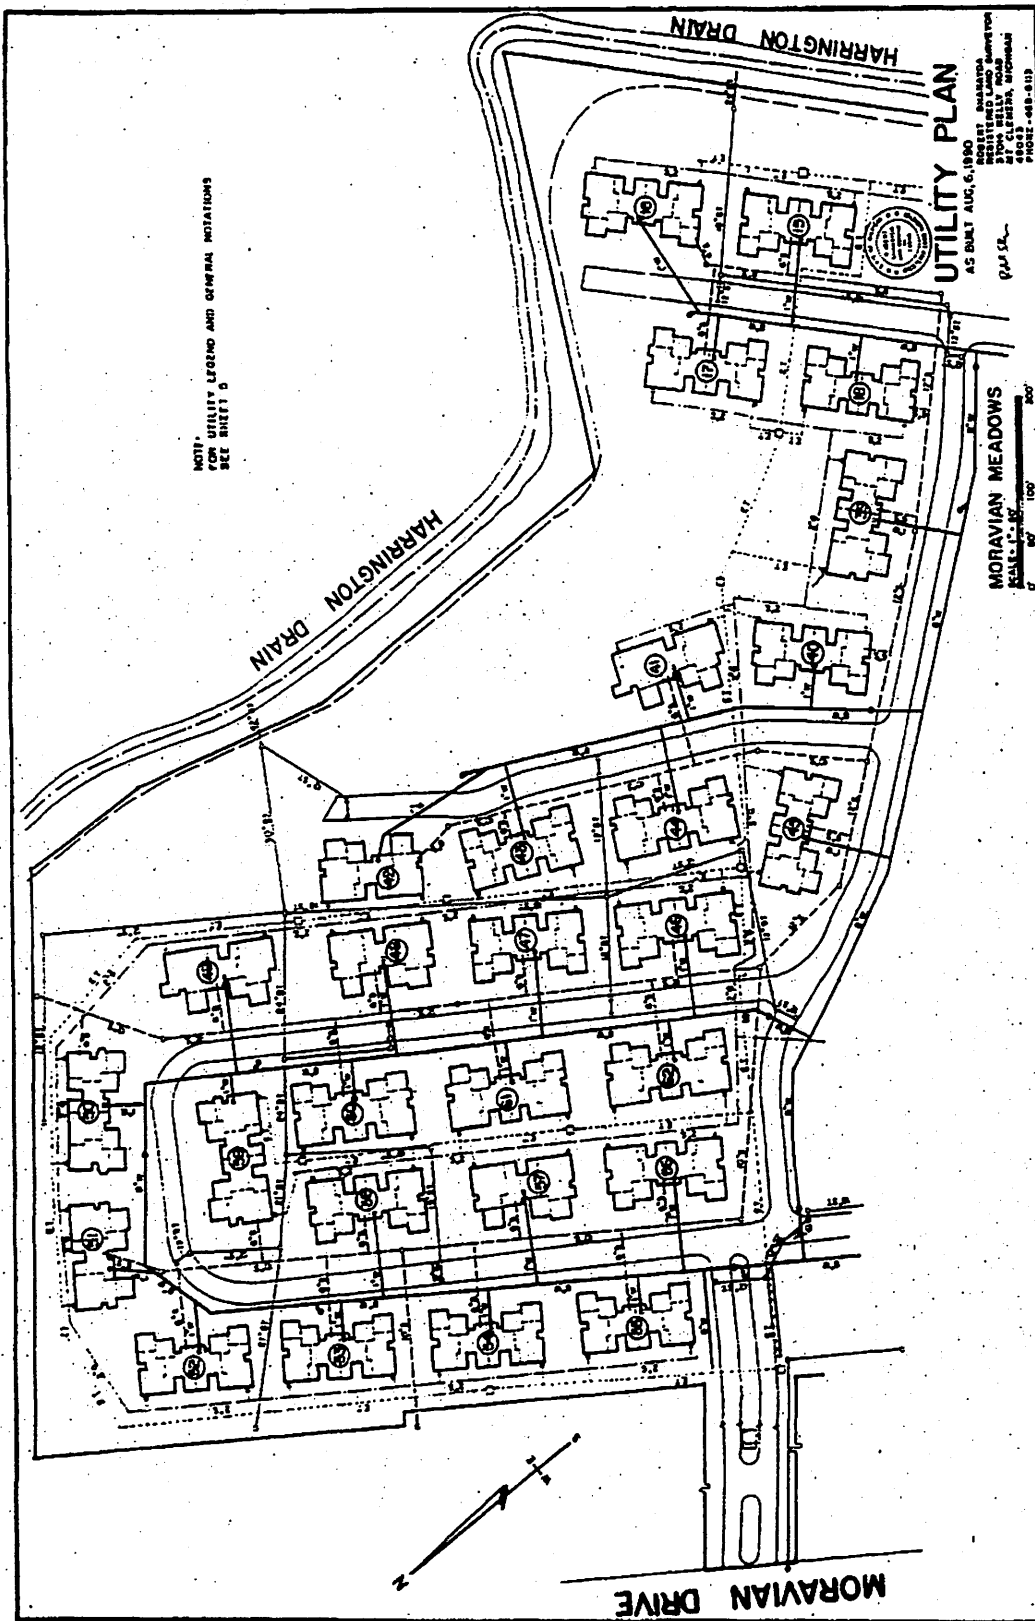


NOTE: FOR UTILITY LEGEND AND GENERAL NOTATIONS SEE SHEET 5

UTILITY PLAN
 AS BUILT AUG. 6, 1990
 REGISTERED LAND SURVEYOR
 PROJECT 488-0113
 SHEET 6

MORAVIAN MEADOWS
 0 50 100 200
 FEET

LIBER 06100 PG 713

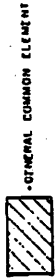

GENERAL COMMON ELEMENT

LIMITS OF OWNERSHIP

COORDINATE POINT

NOTE - ALL EXTERIOR AND INTERIOR BASEMENT WALLS ARE 085" THICK
- ALL WALLS ARE AT RIGHT ANGLES TO EACH OTHER

- ALL EXTERIOR FIRST FLOOR WALLS ARE 075" THICK

P - PORCH, LIMITED COMMON ELEMENT

GARAGE - LIMITED COMMON ELEMENT

AS BUILT AUG. 6 1990







SHEET 7

BUILDING I

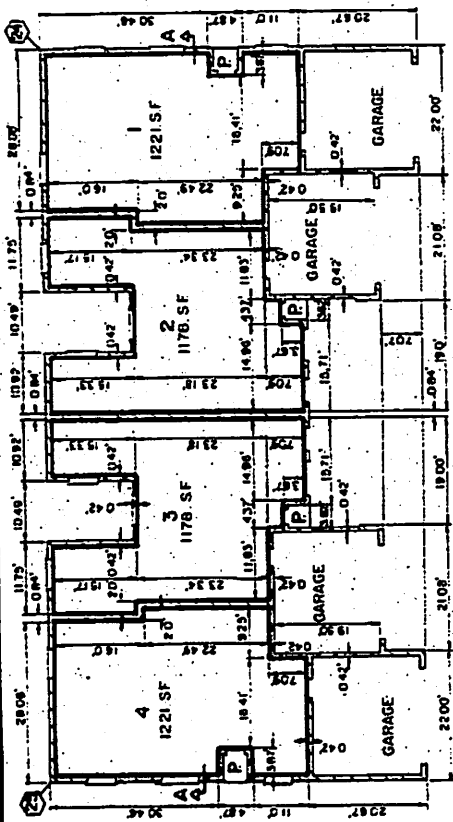

FIRST FLOOR PLAN

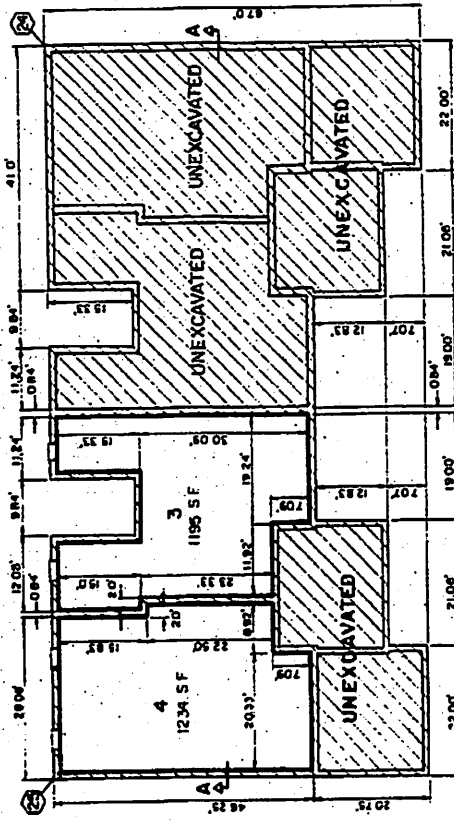

BASEMENT PLAN

LIBER 0610070714

GENERAL COMMON ELEMENT

LIMITS OF OWNERSHIP

COORDINATE POINT

NOTE - ALL EXTERIOR AND INTERIOR BASEMENT WALLS ARE 0'8"

ALL WALLS ARE AT RIGHT ANGLES TO EACH OTHER

ALL EXTERIOR FIRST FLOOR WALLS ARE 0'7"

P - PORCH, LIMITED COMMON ELEMENT

GARAGE - LIMITED COMMON ELEMENT


NOTE - BUILDINGS 2 AND 3 DO NOT HAVE BASEMENTS




AS BUILT AIG, 6 1990
MORAVIAN MEADOWS
REGISTERED LAND SURVEYOR


SHEET 8

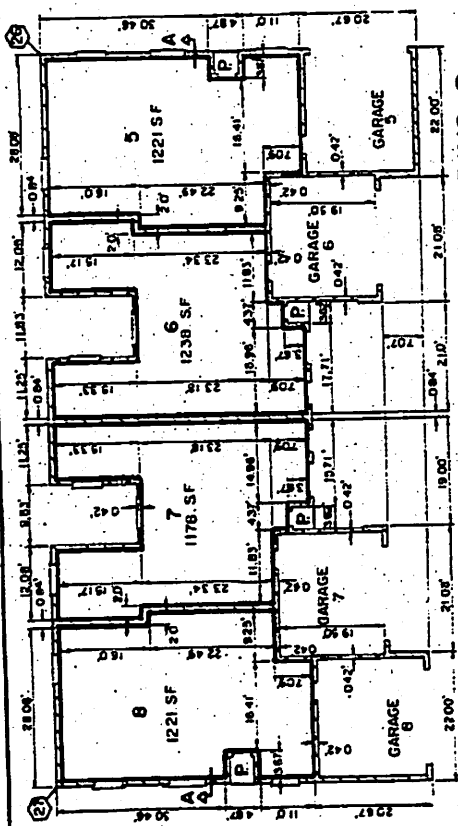

FIRST FLOOR PLAN BUILDING 2

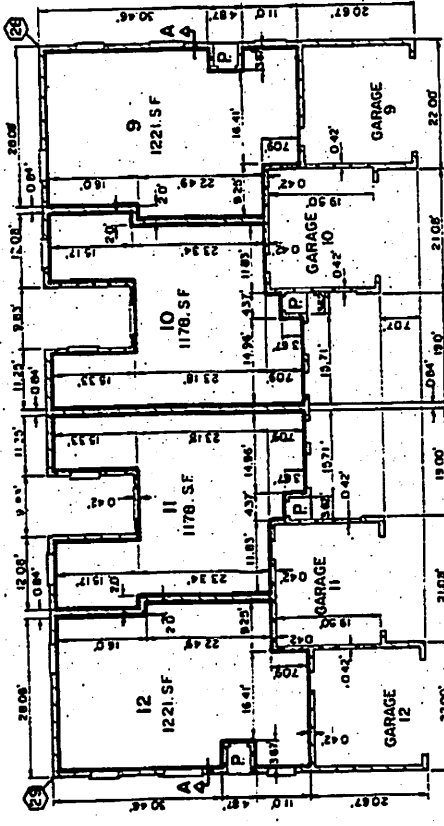

FIRST FLOOR PLAN BUILDING 3

LIBER 06100 PG 715



GENERAL COMMON ELEMENT

LIMITS OF OWNERSHIP

COORDINATE POINT

NOTE: ALL EXTERIOR AND INTERIOR BASEMENT WALLS ARE 0'6"

ALL WALLS ARE AT RIGHT ANGLES TO EACH OTHER

ALL EXTERIOR FIRST FLOOR WALLS ARE 0'75"

P: PORCH, LIMITED COMMON ELEMENT

GARAGE: LIMITED COMMON ELEMENT


NOTE: BUILDINGS 4 AND 5 DO NOT HAVE BASEMENTS




AS BUILT AUG. 5, 1990
MORAVIAN MEADOWS
REGISTERED LAND SURVEYOR
3704 ELLY ROAD
48023 WEAVER, MICHIGAN
PHONE: 488-0113

MORAVIAN MEADOWS
BUILDING 4 & 5


SHEET 9

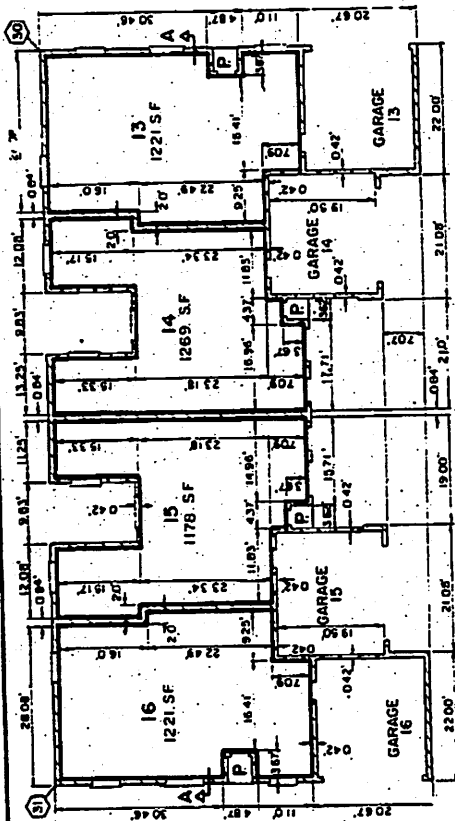


FIRST FLOOR PLAN BUILDING 4

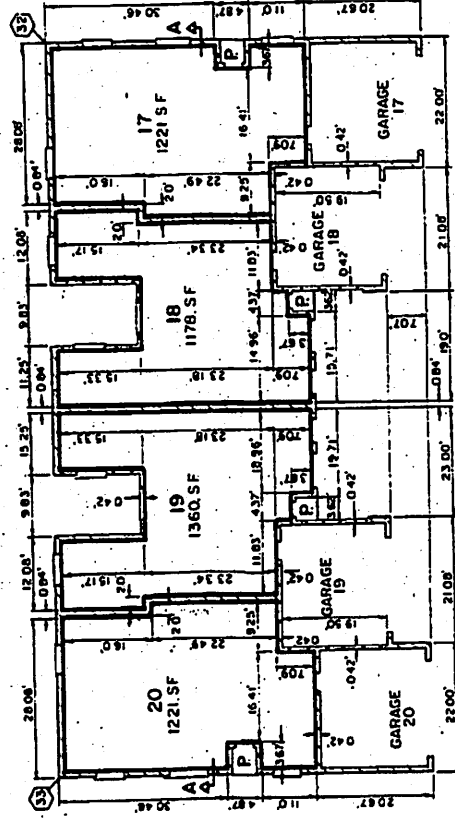

FIRST FLOOR PLAN BUILDING 5

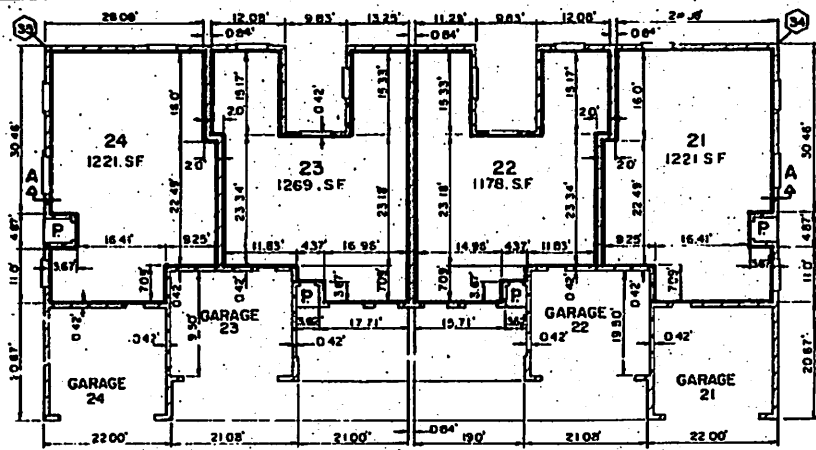

FIRST FLOOR PLAN BUILDING 6

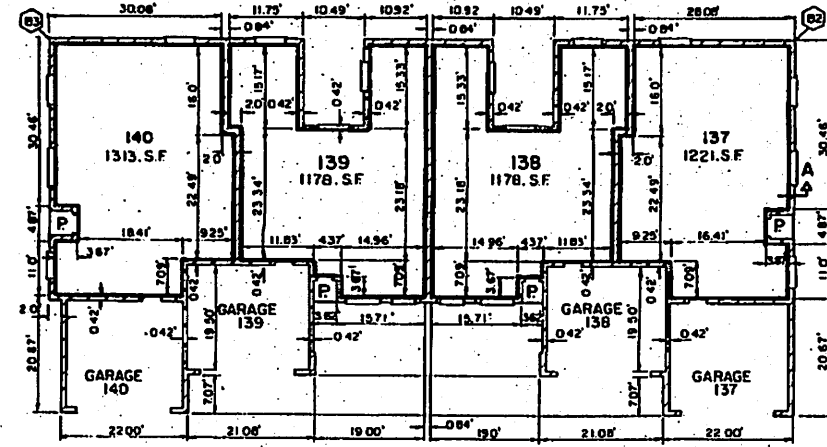

FIRST FLOOR PLAN BUILDING 35



GENERAL COMMON ELEMENT



LIMITS OF OWNERSHIP



COORDINATE POINT

NOTE - ALL EXTERIOR AND INTERIOR BASEMENT WALLS ARE DB'S

- ALL WALLS ARE AT RIGHT ANGLES TO EACH OTHER

- ALL EXTERIOR FIRST FLOOR WALLS ARE 075'

P - PORCH, LIMITED COMMON ELEMENT

GARAGE - LIMITED COMMON ELEMENT

NOTE - BUILDINGS 6, 35 DO NOT HAVE A BASEMENT.

LIB# 061007716




AS BUILT AUG, 6 1990

MORAVIAN MEADOWS


SCALE 1/4" = 1'-0"

ROBERT SHARATKA
REGISTERED LAND SURVEYOR
37014 KELLY ROAD
N.E. CLEMENS, MICHIGAN
48043
PHONE -468-6113

SHEET 10

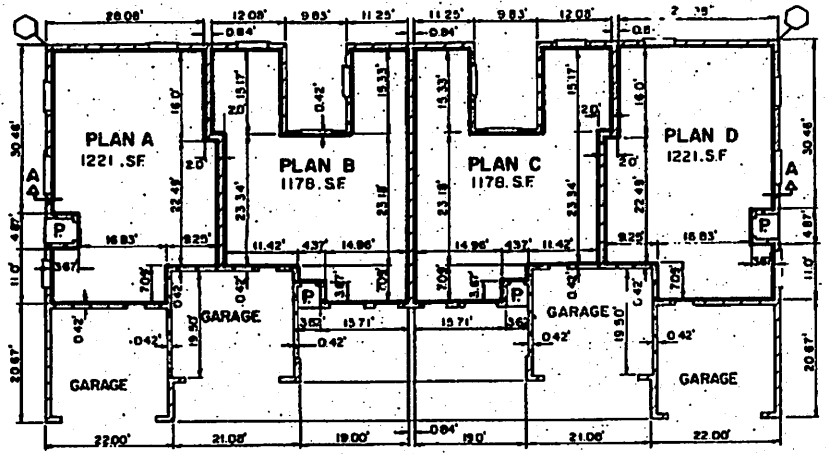

FIRST FLOOR PLAN

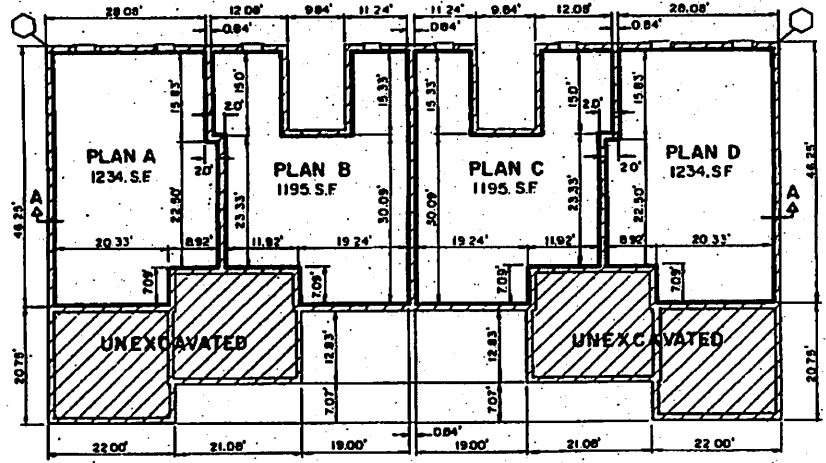

BASEMENT PLAN

- GENERAL COMMON ELEMENT
- LIMITS OF OWNERSHIP
- COORDINATE POINT

NOTE - ALL EXTERIOR AND INTERIOR BASEMENT WALLS ARE 08"
 - ALL WALLS ARE AT RIGHT ANGLES TO EACH OTHER
 - ALL EXTERIOR FIRST FLOOR WALLS ARE 075"
 P - PORCH, LIMITED COMMON ELEMENT
 GARAGE - LIMITED COMMON ELEMENT
 NOTE - FOR CORNER UNITS ONLY, FRONT OR SIDE ENTRANCE TO GARAGE OPTIONAL, SEE SITE PLAN FOR GARAGE ENTRANCE

SCHEDULE OF UNIT NUMBERS

BLDG. NUMBER	UNIT NUMBERS			
	PLAN A	PLAN B	PLAN C	PLAN D
7	28	27	26	25
8	32	31	30	29
9	36	35	34	33
37	148	147	146	145
47	188	187	186	185


BUILDINGS 7,8,9,37, 47

MORAVIAN MEADOWS
 SCALE 1/8" = 1'-0"




AS BUILT AUG. 6 1990
 ROBERT ZHAYADA
 REGISTERED LAND SURVEYOR
 3704 WELLY ROAD
 MT CLEMENS, MICHIGAN
 48043
 PHONE -488-6113

06100P0717

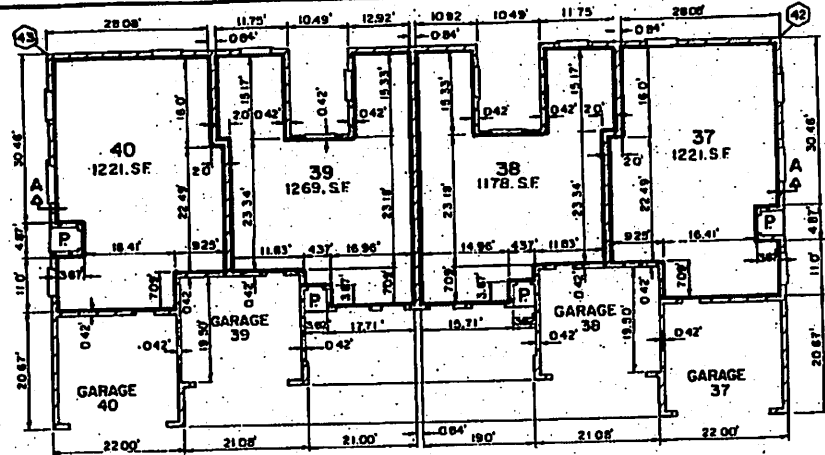

FIRST FLOOR PLAN

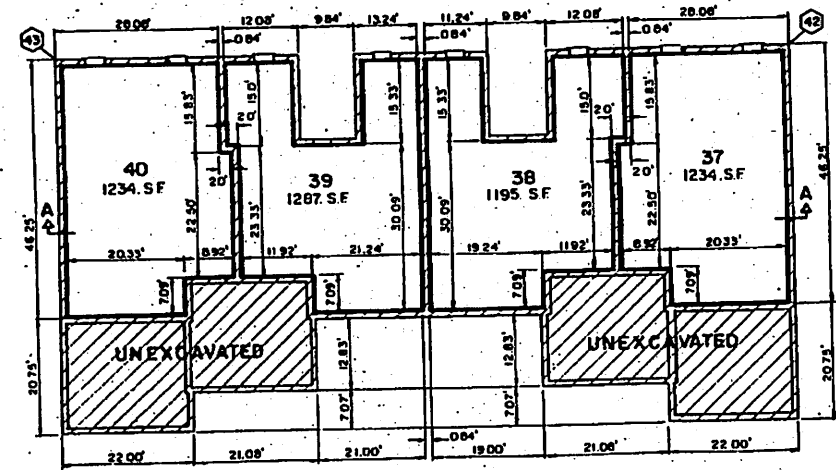

BASEMENT PLAN

BUILDING 10

MORAVIAN MEADOWS
 SCALE: 1/8" = 1'-0"






AS BUILT AUG. 6, 1990
 ROBERT SHARATDA
 REGISTERED LAND SURVEYOR
 37014 KELLY ROAD
 MT CLEMENS, MICHIGAN
 48043
 PHONE - 468-8113

SHEET 12

URS 0610010718

LIBER 06100PG719

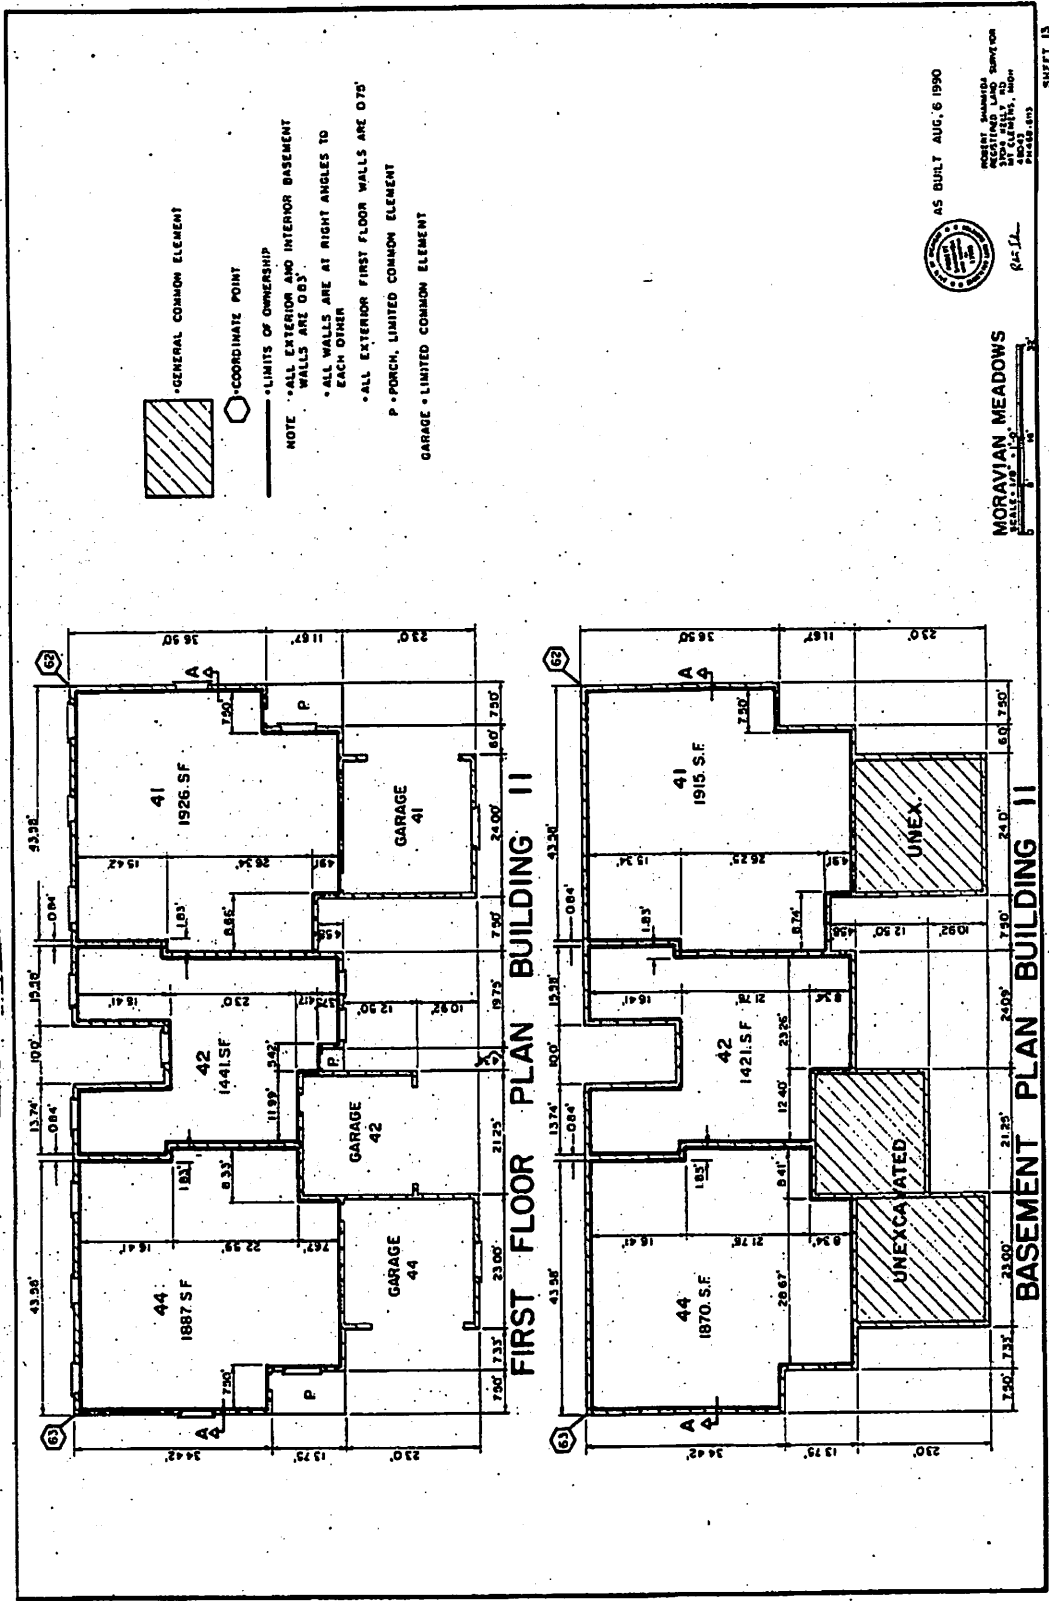

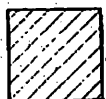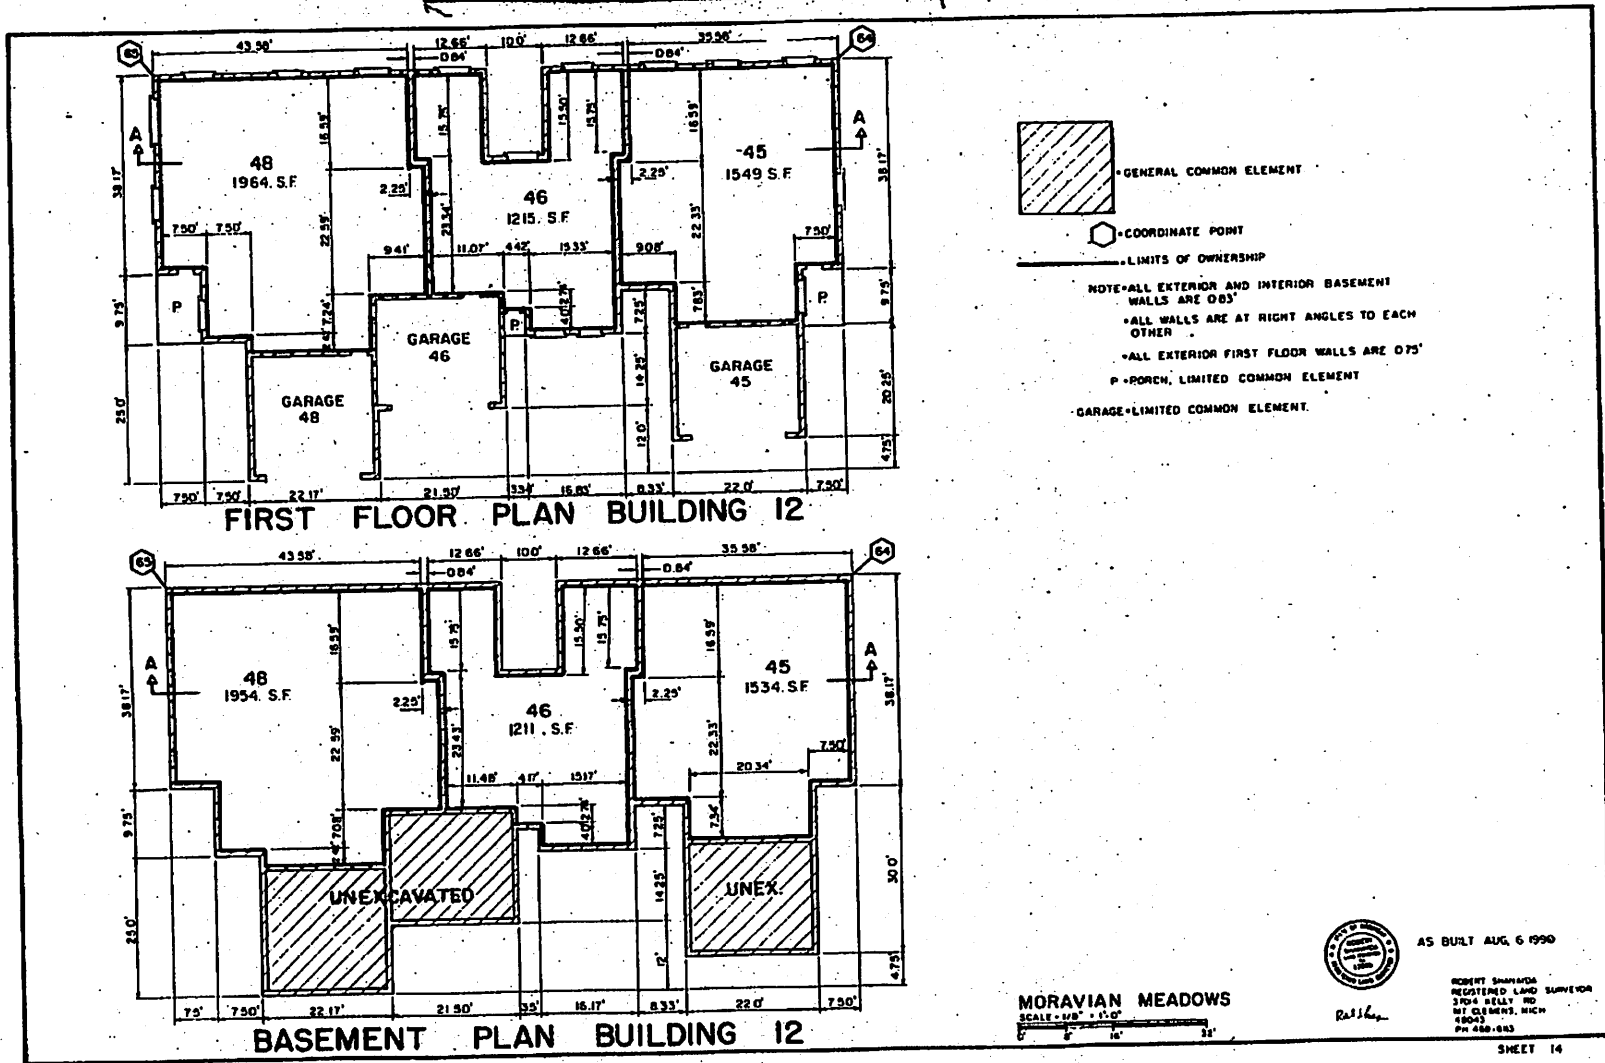

GENERAL COMMON ELEMENT

COORDINATE POINT

LIMITS OF OWNERSHIP

NOTE-ALL EXTERIOR AND INTERIOR BASEMENT WALLS ARE 083"

ALL WALLS ARE AT RIGHT ANGLES TO EACH OTHER

ALL EXTERIOR FIRST FLOOR WALLS ARE 075"

P-PORCH, LIMITED COMMON ELEMENT

GARAGE-LIMITED COMMON ELEMENT

FIRST FLOOR PLAN BUILDING 12

BASEMENT PLAN BUILDING 12

LIB# 061008720



AS BUILT AUG. 6 1990


MORAVIAN MEADOWS

SCALE - 1/8" = 1'-0"


Robert Sharda

ROBERT SHARDA
REGISTERED LAND SURVEYOR
3704 KELLY RD
MT CLEMENS, MICH
48043
PH 486-083

SHEET 14

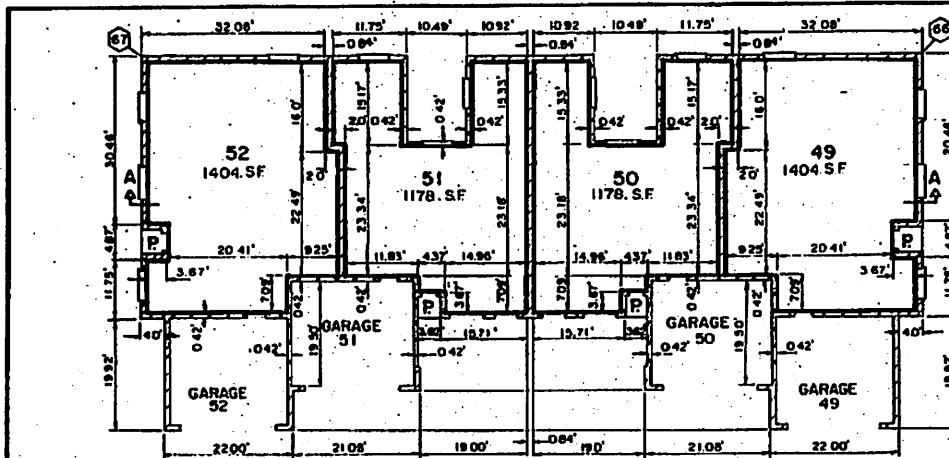

FIRST FLOOR PLAN

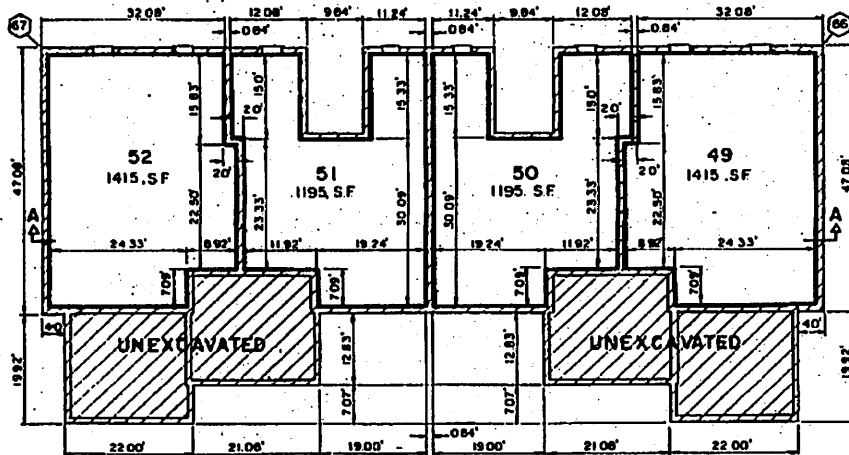

BASEMENT PLAN



GENERAL COMMON ELEMENT

LIMITS OF OWNERSHIP



NOTE - ALL EXTERIOR AND INTERIOR BASEMENT WALLS ARE 08"

- ALL WALLS ARE AT RIGHT ANGLES TO EACH OTHER

- ALL EXTERIOR FIRST FLOOR WALLS ARE 07 1/2"

P - PORCH, LIMITED COMMON ELEMENT

GARAGE - LIMITED COMMON ELEMENT

NOTE - FOR CORNER UNITS ONLY, FRONT OR SIDE ENTRANCE TO GARAGE OPTIONAL, SEE SITE PLAN FOR GARAGE ENTRANCE

BUILDING 13

MORAVIAN MEADOWS

SCALE - 1/8" = 1'-0"

0' 5' 10'




AS BUILT AUG. 6, 1990

ROBERT BRANATDA
REGISTERED LAND SURVEYOR
37504 KELLY ROAD
M1 CLEMENS, MICHIGAN
48043
PHONE 486-8113

SHEET 13

1182 06100P1721

LIBER 06100 PG 722

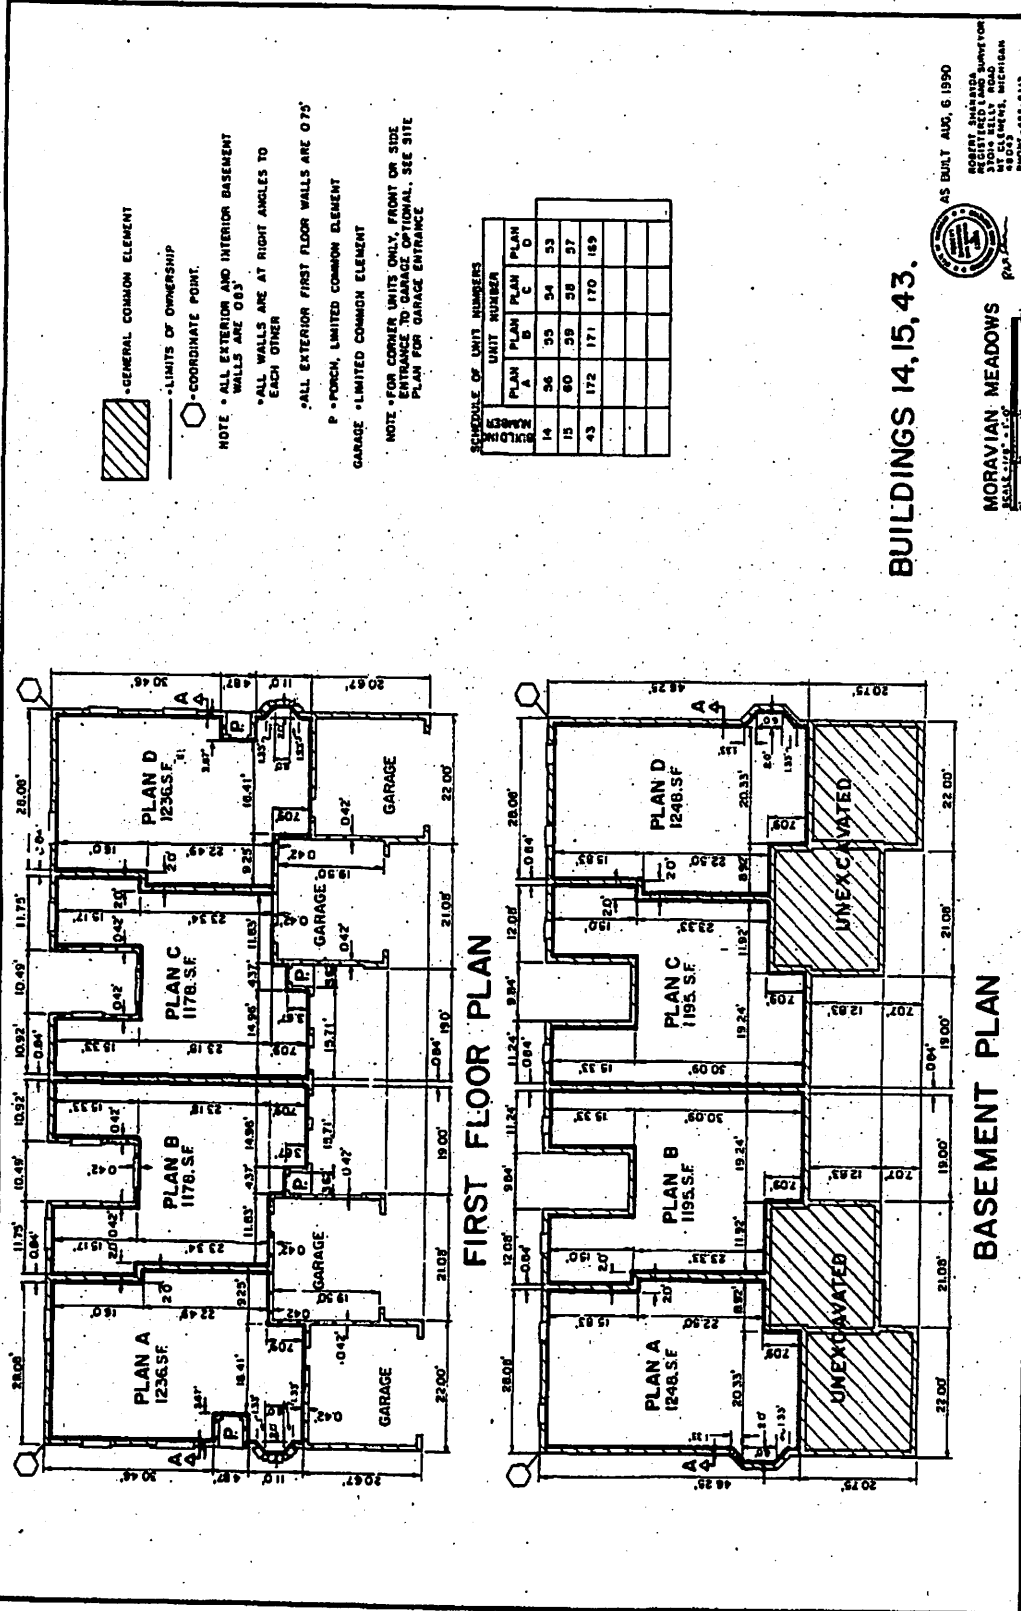

- GENERAL COMMON ELEMENT
- LIMITS OF OWNERSHIP
- COORDINATE POINT


NOTE - ALL EXTERIOR AND INTERIOR BASEMENT WALLS ARE 0'3" EACH OTHER
 - ALL WALLS ARE AT RIGHT ANGLES TO EACH OTHER
 - ALL EXTERIOR FIRST FLOOR WALLS ARE 0'75" P - PORCH, LIMITED COMMON ELEMENT
 GARAGE - LIMITED COMMON ELEMENT

NOTE - FOR CORNER UNITS ONLY, FRONT OR SIDE ENTRANCE TO GARAGE OPTIONAL, SEE SITE PLAN FOR GARAGE ENTRANCE

SCHEDULE OF UNIT NUMBERS

PLAN	PLAN A	PLAN B	PLAN C	PLAN D
14	56	55	54	53
43	172	171	170	169

BUILDINGS 14, 15, 43.

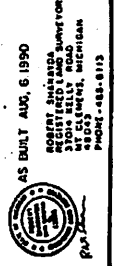


MORAVIAN MEADOWS

AS BUILT AUG. 6 1990

SHEET 10

LIBER 06100 PG 723

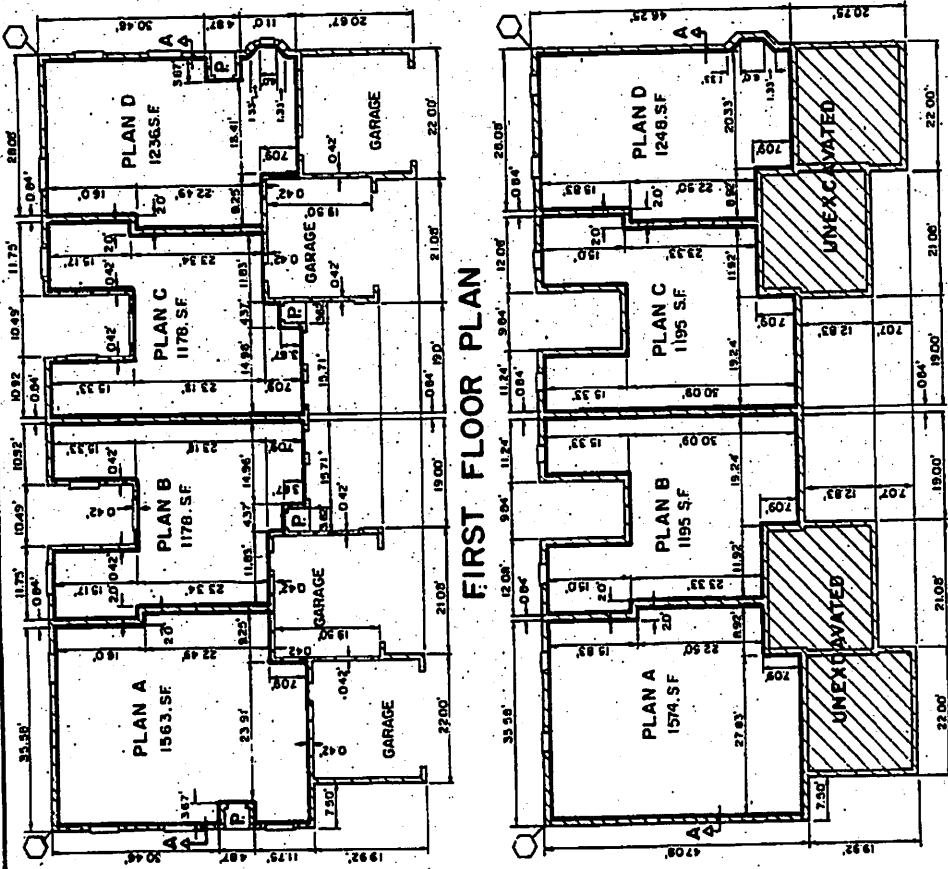


FIRST FLOOR PLAN

BASEMENT PLAN



GENERAL COMMON ELEMENT

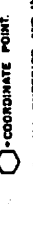

LIMITS OF OWNERSHIP

NOTE: ALL EXTERIOR AND INTERIOR BASEMENT WALLS ARE 0'6"

ALL WALLS ARE AT RIGHT ANGLES TO EACH OTHER

ALL EXTERIOR FIRST FLOOR WALLS ARE 0'75"

P - PORCH, LIMITED COMMON ELEMENT

GARAGE - LIMITED COMMON ELEMENT

NOTE: FOR CORNER UNITS ONLY, FRONT OR SIDE ENTRANCE TO GARAGE OPTIONAL, SEE SITE PLAN FOR GARAGE ENTRANCE

SCHEDULE OF UNIT NUMBERS

BLOC	PLAN	PLAN	PLAN	PLAN
NA	A	B	C	D
16	84	83	82	81
39	185	186	184	183
56	224	223	222	221

NOTE: BUILDING 56 UNITS 221 AND 222 HAVE NO BASEMENTS


BUILDING 16.39.56

AS BUILT AUG. 6 1990
 PHONE: 482-8113



MORAVIAN MEADOWS
 SCALE: 1/8" = 1'-0"
 SHEET 17

LIBER 06100 PG 724

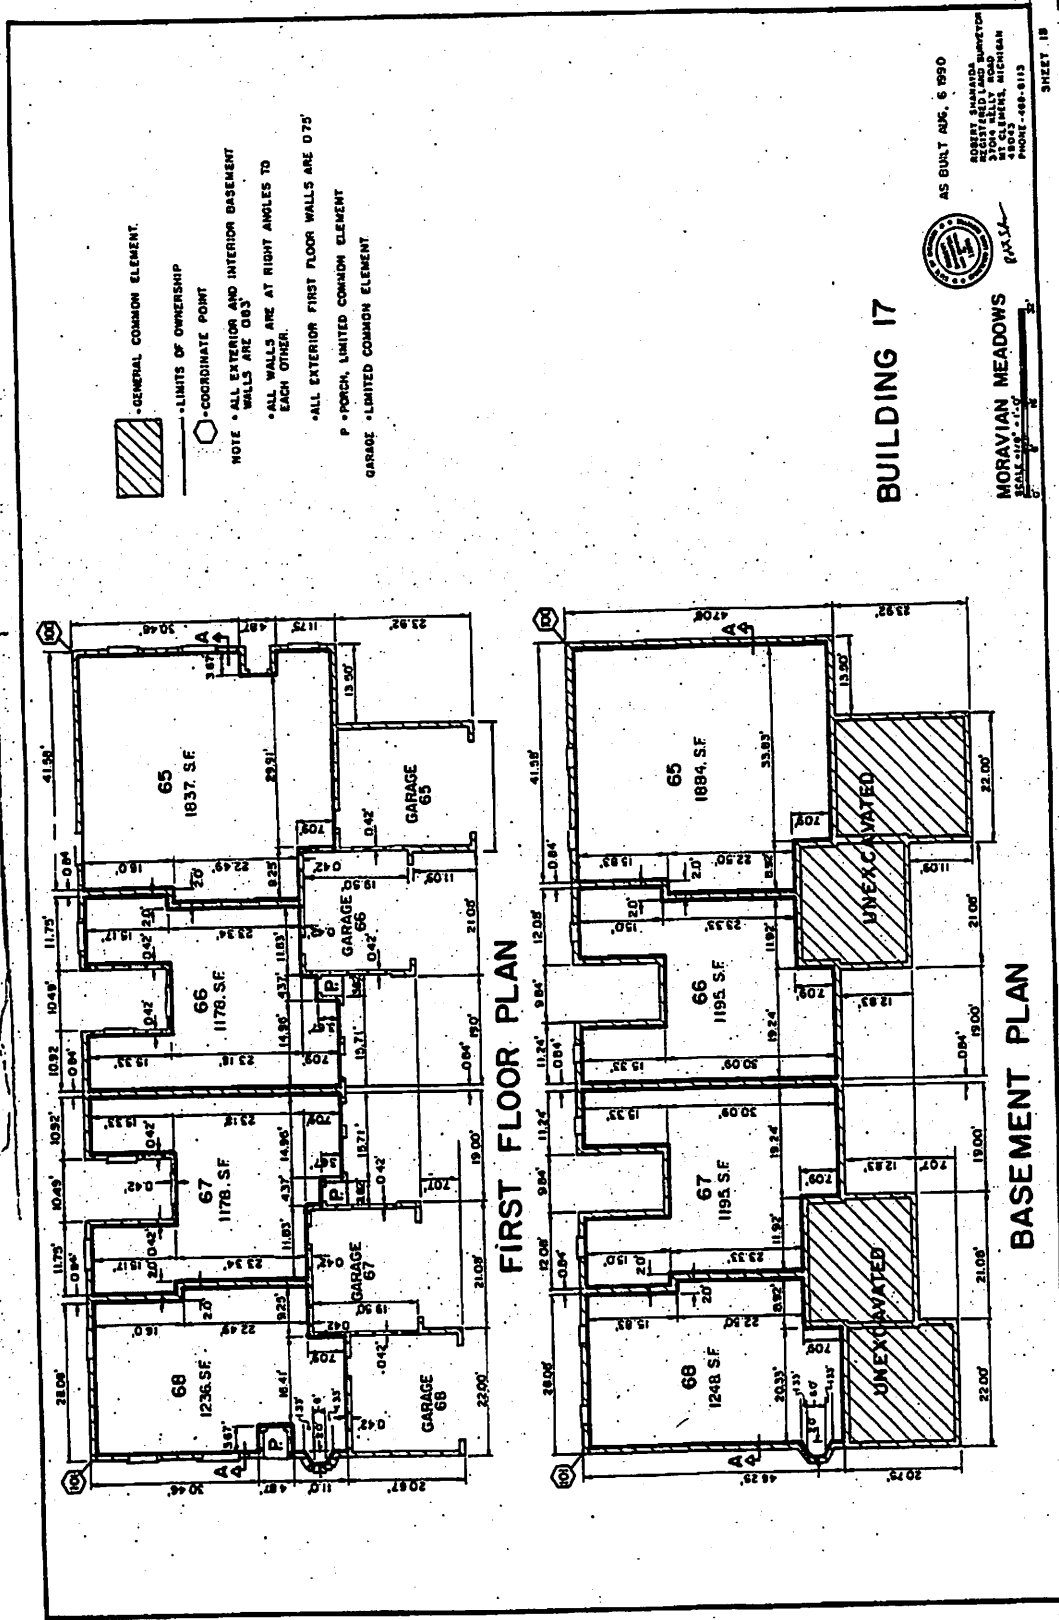

-GENERAL COMMON ELEMENT.
 -LIMITS OF OWNERSHIP
 -COORDINATE POINT
 NOTE - ALL EXTERIOR AND INTERIOR BASEMENT WALLS ARE 083"
 *ALL WALLS ARE AT RIGHT ANGLES TO EACH OTHER.
 *ALL EXTERIOR FIRST FLOOR WALLS ARE 075"
 P -PORCH, LIMITED COMMON ELEMENT
 GARAGE -LIMITED COMMON ELEMENT

BUILDING 17

AS BUILT R/W, 6 1990
 3104 KELLY ROAD
 ST. CLEMENS, MICHIGAN
 PHONE -482-9113




MORAVIAN MEADOWS
 SCALE: 1/8" = 1'-0"
 SHEET 18

FIRST FLOOR PLAN

BASEMENT PLAN

06100P0725

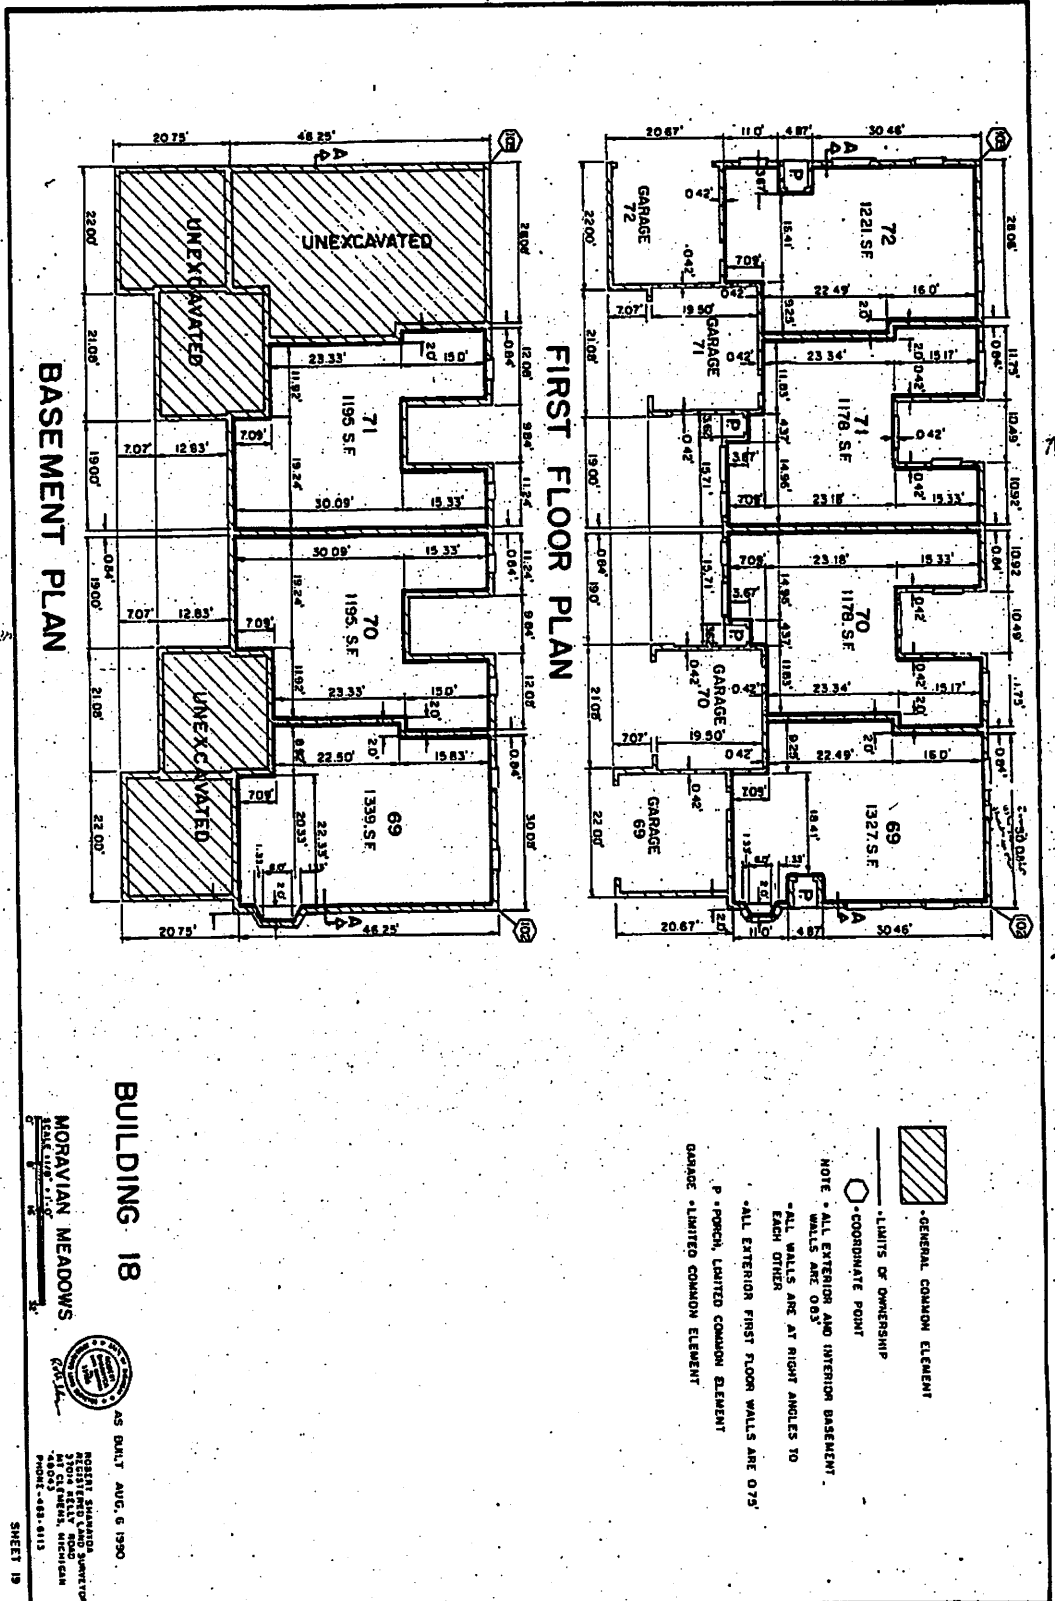

LIBER 06100 Pt 726


-GENERAL COMMON ELEMENT
 -LIMITS OF OWNERSHIP
 -COORDINATE POINT
 NOTE - ALL EXTERIOR AND INTERIOR BASEMENT WALLS ARE 0'75" EACH OTHER
 -ALL EXTERIOR FIRST FLOOR WALLS ARE 0'75"
 P - PORCH, LIMITED COMMON ELEMENT
 GARAGE - LIMITED COMMON ELEMENT

AS BUILT AUG. 6 1990
 ROBERT SHANNON
 REGISTERED LAND SURVEYOR





MORAVIAN MEADOWS
 SCALE: 1/4" = 1'-0"

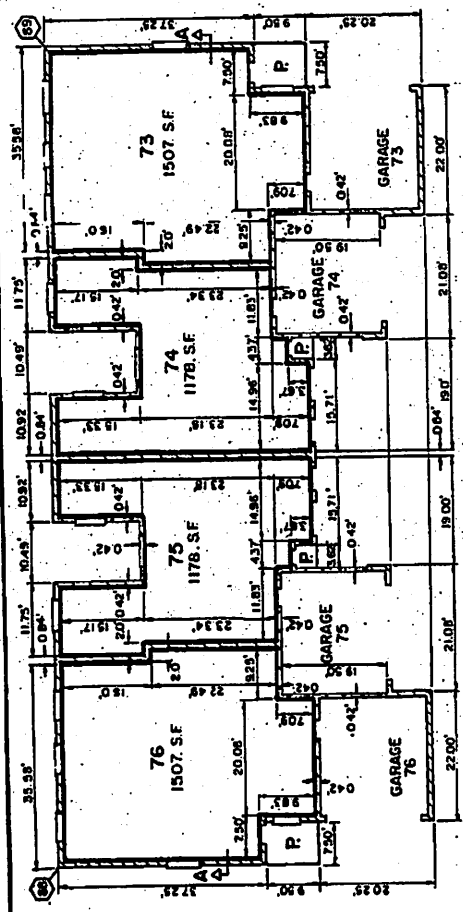

FIRST FLOOR PLAN

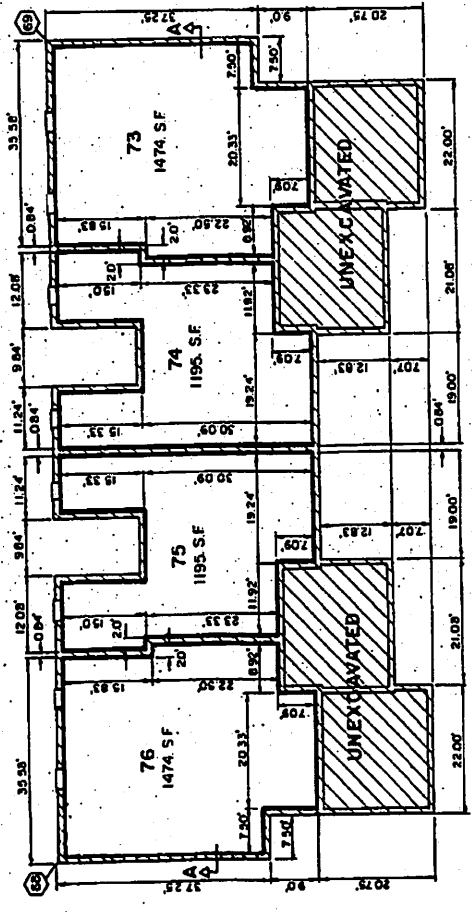

BASEMENT PLAN

LIBER 06100 PG 727

SHEET 21



-GENERAL COMMON ELEMENT

-LIMITS OF OWNERSHIP

-COORDINATE POINT

NOTE - ALL EXTERIOR AND INTERIOR BASEMENT WALLS ARE 0.83'

-ALL WALLS ARE AT RIGHT ANGLES TO EACH OTHER

-ALL EXTERIOR FIRST FLOOR WALLS ARE 0.75'

P - PORCH, LIMITED COMMON ELEMENT

GARAGE - LIMITED COMMON ELEMENT

BUILDING 20


MORAVIAN MEADOWS

AS-BUILT AUG 6, 1990




ROBERT SHAWANDA



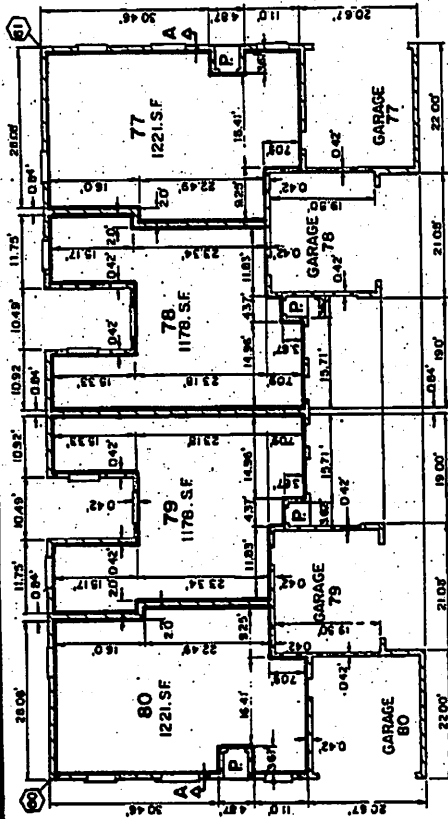


FIRST FLOOR PLAN

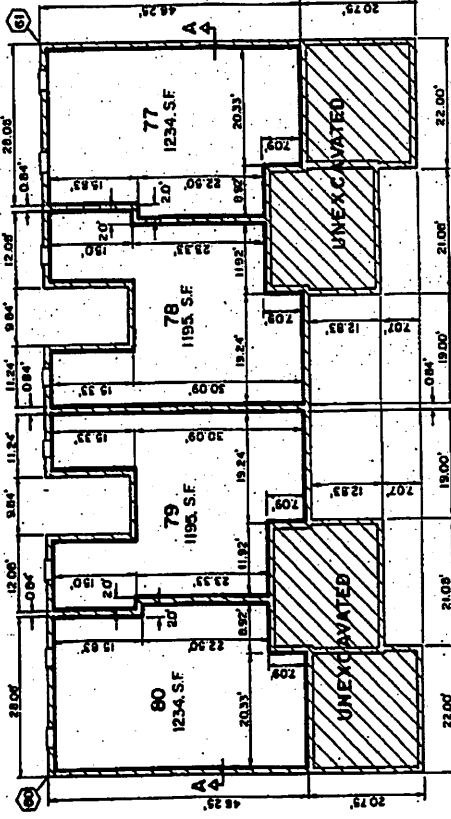

BASEMENT PLAN

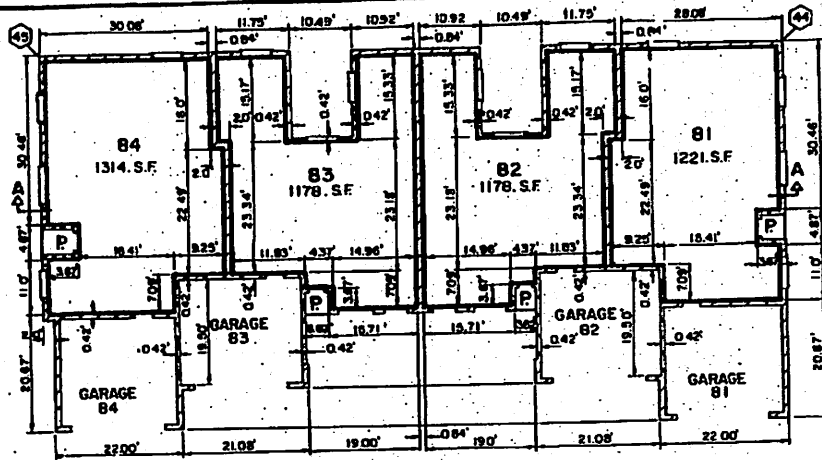

FIRST FLOOR PLAN

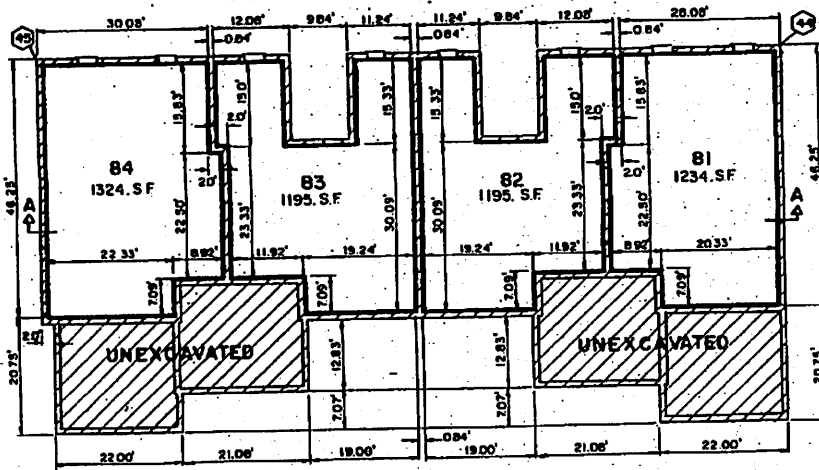

BASEMENT PLAN



GENERAL COMMON ELEMENT



LIMITS OF OWNERSHIP



COORDINATE POINT

NOTE - ALL EXTERIOR AND INTERIOR BASEMENT WALLS ARE 0.8'

- ALL WALLS ARE AT RIGHT ANGLES TO EACH OTHER.

- ALL EXTERIOR FIRST FLOOR WALLS ARE 0.75'

P - PORCH, LIMITED COMMON ELEMENT

GARAGE - LIMITED COMMON ELEMENT

LINE 061001728

BUILDING 21




MORAVIAN MEADOWS
SCALE 1/8" = 1'-0"



AS-BUILT AUG 6, 1990
 ROBERT SHANAVDA
 REGISTERED LAND SURVEYOR
 37014 SELLY ROAD
 MT CLEMENS, MICHIGAN
 48043
 PHONE - 488-8115

SHEET 22

LIBER 06100 PG 729

 - GENERAL COMMON ELEMENT
 - LIMITS OF OWNERSHIP
 - COORDINATE POINT
 NOTE - ALL EXTERIOR AND INTERIOR BASEMENT WALLS ARE 0.75'
 * ALL WALLS ARE AT RIGHT ANGLES TO EACH OTHER
 * ALL EXTERIOR FIRST FLOOR WALLS ARE 0.75'
 P - PORCH, LIMITED COMMON ELEMENT
 GARAGE - LIMITED COMMON ELEMENT


BUILDING 22




MORAVIAN MEADOWS
 SCALE: 1/8" = 1'-0"
 1" = 12'-0"

AS-BUILT AUG. 6, 1990


SHEET 23

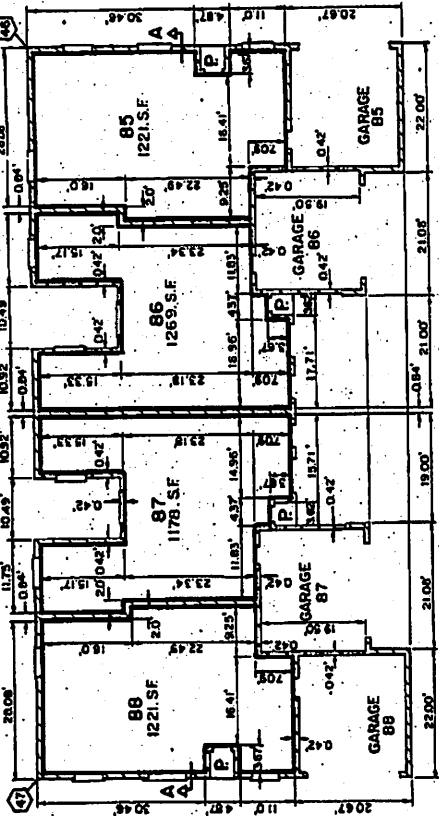


FIRST FLOOR PLAN

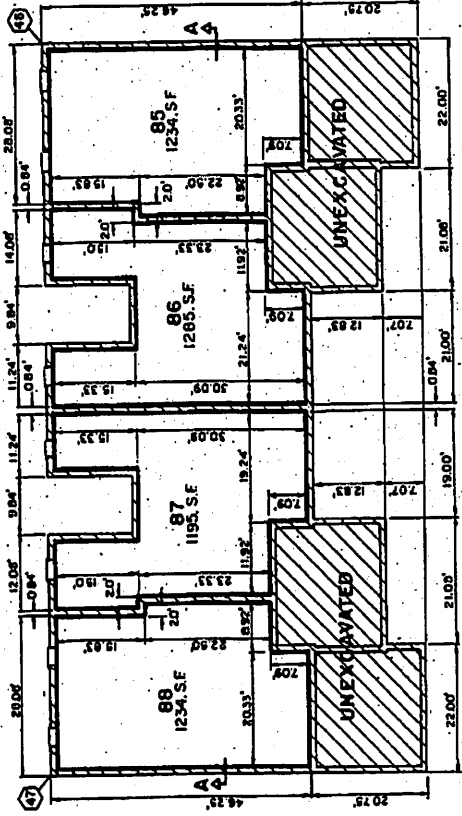

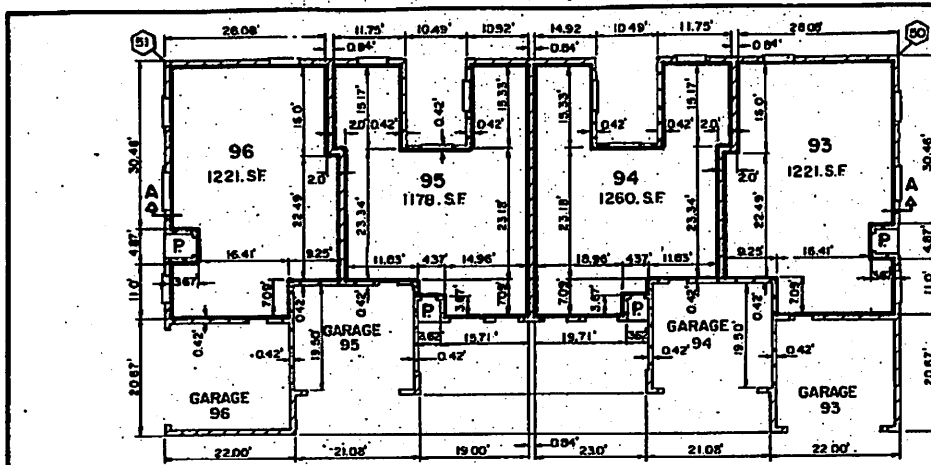


BASEMENT PLAN

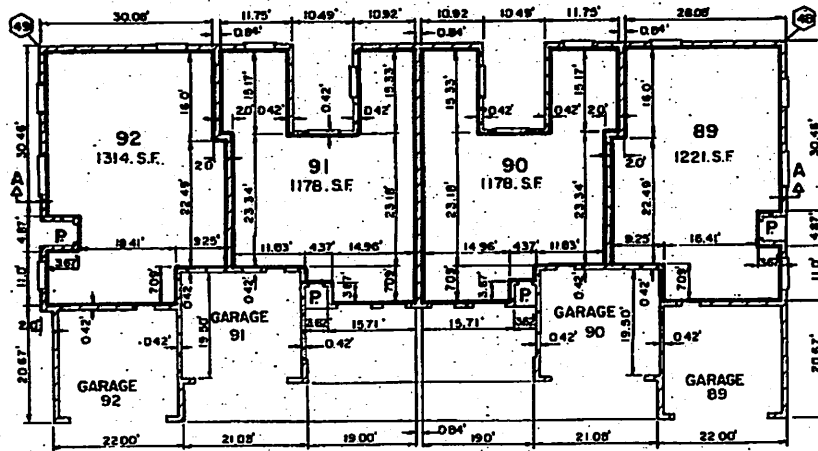

FIRST FLOOR PLAN BUILDING 24



FIRST FLOOR PLAN BUILDING 23

-  -GENERAL COMMON ELEMENT
-  -LIMITS OF OWNERSHIP
-  -COORDINATE POINT.
- NOTE - ALL EXTERIOR AND INTERIOR BASEMENT WALLS ARE 0.83'
- ALL WALLS ARE AT RIGHT ANGLES TO EACH OTHER.
- ALL EXTERIOR FIRST FLOOR WALLS ARE 0.75'
- P -PORCH, LIMITED COMMON ELEMENT
- GARAGE -LIMITED COMMON ELEMENT

NOTE - BUILDINGS 23 AND 24 DO NOT HAVE BASEMENTS.


USER 061001730

MORAVIAN MEADOWS

AS-BUILT AUG 6, 1990

ROBERT SHANAYDA
REGISTERED LAND SURVEYOR
3704 KELLY ROAD
MT CLEMENS, MICHIGAN
48043
PHONE -488-6113


SCALE - 1/8" = 1'-0"



Robert Shanayda

SHEET 24

LIBER 06100PG 731

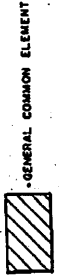

• GENERAL COMMON ELEMENT

• LIMITS OF OWNERSHIP

○ COORDINATE POINT

NOTE • ALL EXTERIOR AND INTERIOR BASEMENT WALLS ARE 0'8"

• ALL WALLS ARE AT RIGHT ANGLES TO EACH OTHER.

• ALL EXTERIOR FIRST FLOOR WALLS ARE 0'75"

P • PORCH, LIMITED COMMON ELEMENT

GARAGE • LIMITED COMMON ELEMENT


NOTE - BUILDINGS 25 AND 26 DO NOT HAVE BASEMENTS.




AS-BUILT AUG 6, 1990
PHONE -482-8113

MORAVIAN MEADOWS
REVISION 11-11-90


SHEET 26

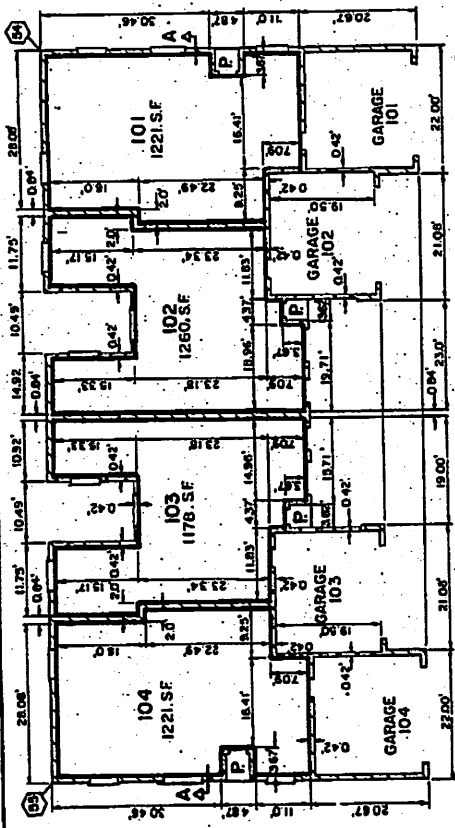


FIRST FLOOR PLAN BUILDING 26

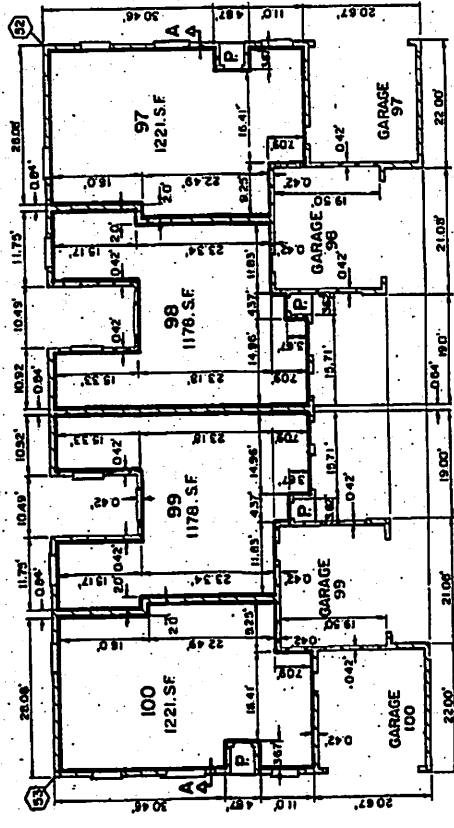

FIRST FLOOR PLAN BUILDING 25

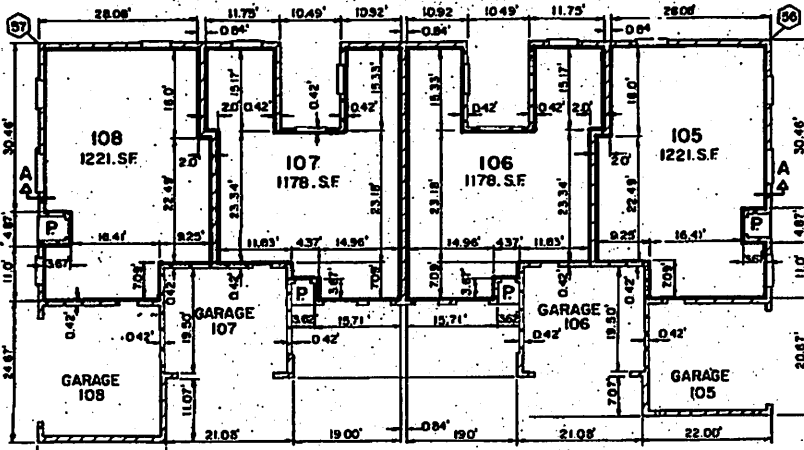

FIRST FLOOR PLAN

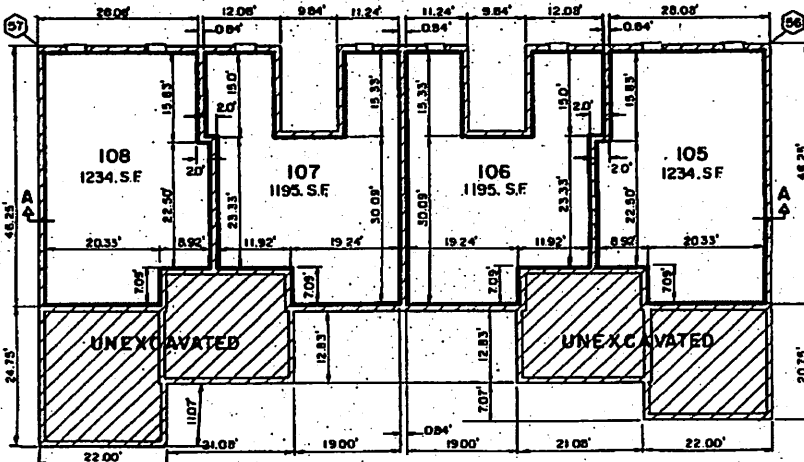

BASEMENT PLAN



GENERAL COMMON ELEMENT

LIMITS OF OWNERSHIP

COORDINATE POINT

NOTE - ALL EXTERIOR AND INTERIOR BASEMENT WALLS ARE 0.83'

ALL WALLS ARE AT RIGHT ANGLES TO EACH OTHER

ALL EXTERIOR FIRST FLOOR WALLS ARE 0.75'

P - PORCH, LIMITED COMMON ELEMENT

GARAGE - LIMITED COMMON ELEMENT

URA 061001732

BUILDING 27

MORAVIAN MEADOWS

SCALE - 1/8" = 1'-0"



AS-BUILT AUG 6, 1990

ROBERT SHANYDA
REGISTERED LAND SURVEYOR
37014 KELLY ROAD
M1 CLEMENS, MICHIGAN
48043
PHONE-468-6113

SHEET 28

LIBER 06100 PG 733



*GENERAL COMMON ELEMENT
 *LIMITS OF OWNERSHIP
 *COORDINATE POINT
 NOTE *ALL EXTERIOR AND INTERIOR BASEMENT WALLS ARE 083"
 *ALL WALLS ARE AT RIGHT ANGLES TO EACH OTHER.
 *ALL EXTERIOR FIRST FLOOR WALLS ARE 075"
 P *PORCH, LIMITED COMMON ELEMENT
 GARAGE *LIMITED COMMON ELEMENT.




AS-BUILT AUG 5, 1990
 REGISTERED LAND SURVEYOR


MORAVIAN MEADOWS
 SCALE: 1/8" = 1'-0"
 3"

BUILDING 28

SHEET 27

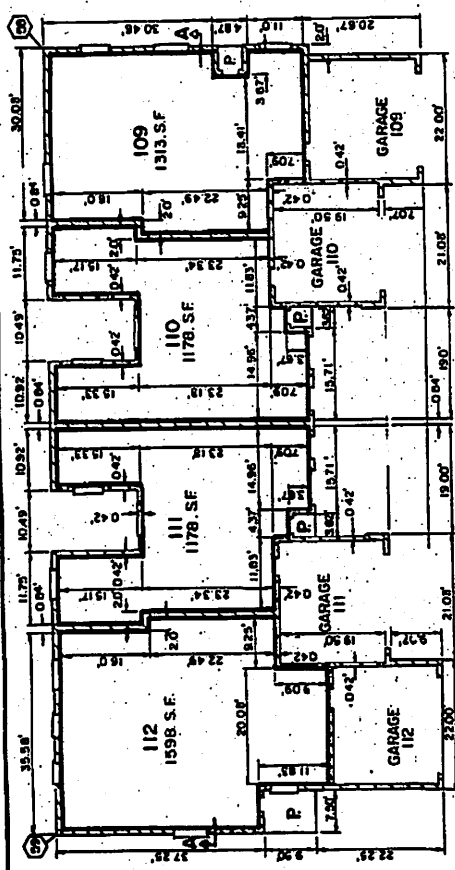

FIRST FLOOR PLAN

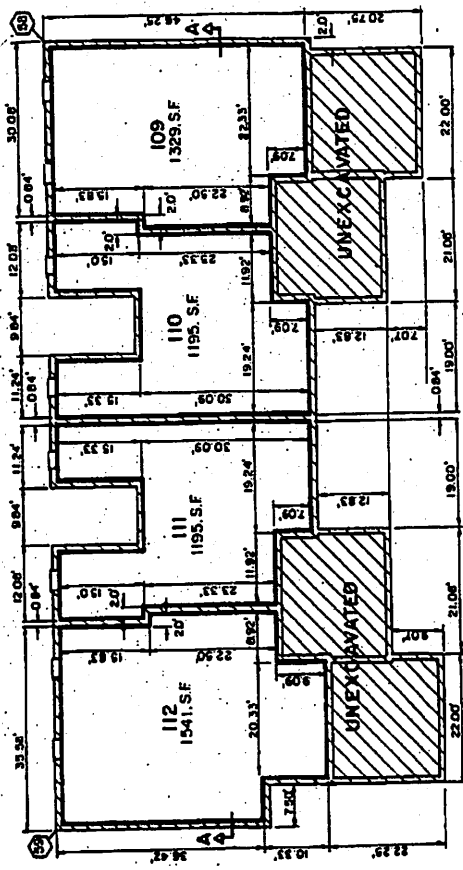

BASEMENT PLAN

LIBER 061000734

SHEET 29

ROBERT SHANAHAN
REGISTERED LAND SURVEYOR
12018 HILLY ROAD
MT CLEMENS, MICHIGAN
48053
PHONE 468-8113




MORAVIAN MEADOWS

BUILDING 29


NOTE • ALL EXTERIOR AND INTERIOR BASEMENT WALLS ARE 0.65' EACH OTHER
• ALL EXTERIOR FIRST FLOOR WALLS ARE 0.75' P-PORCH, LIMITED COMMON ELEMENT
GARAGE - LIMITED COMMON ELEMENT

○ - COORDINATE POINT
▨ - LIMITS OF OWNERSHIP
▨ - GENERAL COMMON ELEMENT

FIRST FLOOR PLAN

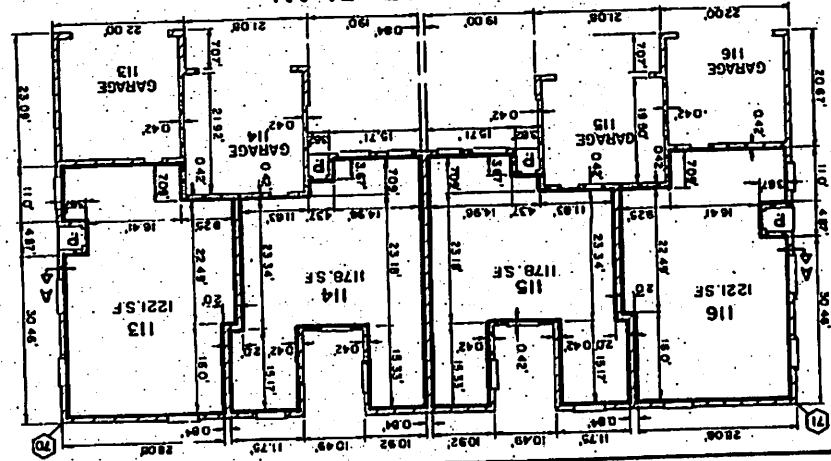

BASEMENT PLAN

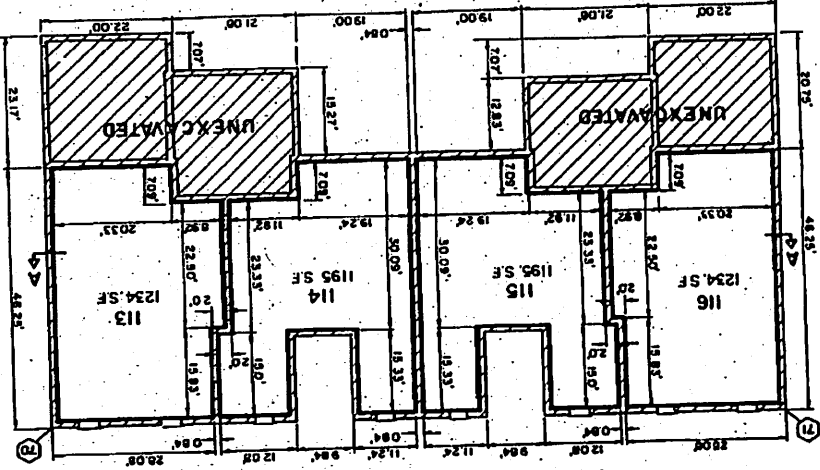

061000200

GENERAL COMMON ELEMENT

LIMITS OF OWNERSHIP

COORDINATE POINT













FIRST FLOOR PLAN

 


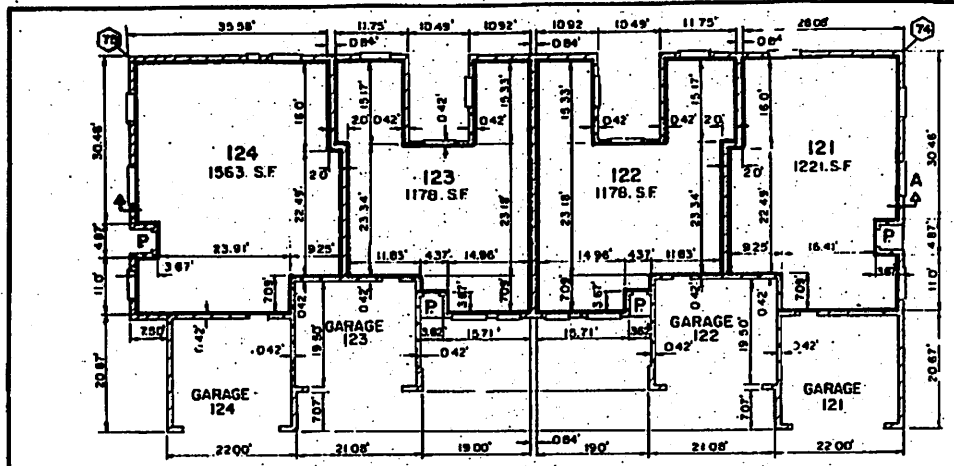

FIRST FLOOR PLAN BUILDING 31

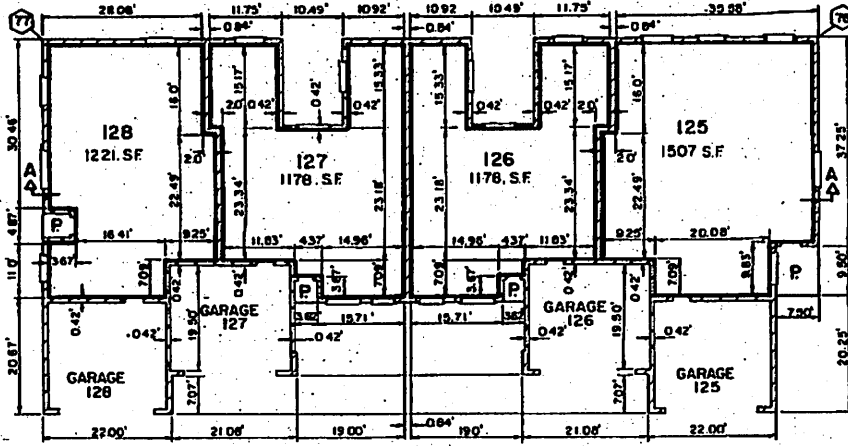

FIRST FLOOR PLAN BUILDING 32

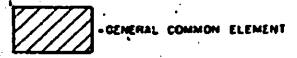

-GENERAL COMMON ELEMENT

-LIMITS OF OWNERSHIP



-COORDINATE POINT

NOTE - ALL EXTERIOR AND INTERIOR BASEMENT WALLS ARE 0.03'

- ALL WALLS ARE AT RIGHT ANGLES TO EACH OTHER

- ALL EXTERIOR FIRST FLOOR WALLS ARE 0.75'

P - PORCH, LIMITED COMMON ELEMENT

GARAGE - LIMITED COMMON ELEMENT

NOTE-BUILDINGS 31 AND 32 DO NOT HAVE BASEMENTS




AS-BUILT AUG 6, 1990
 ROBERT SHARADA
 REGISTERED LAND SURVEYOR
 37014 KELLY ROAD
 Mt CLEMENS, MICHIGAN
 48063
 PHONE - 468-6113


MORAVIAN MEADOWS
 SCALE - 1/8" = 1'-0"

SHEET 30

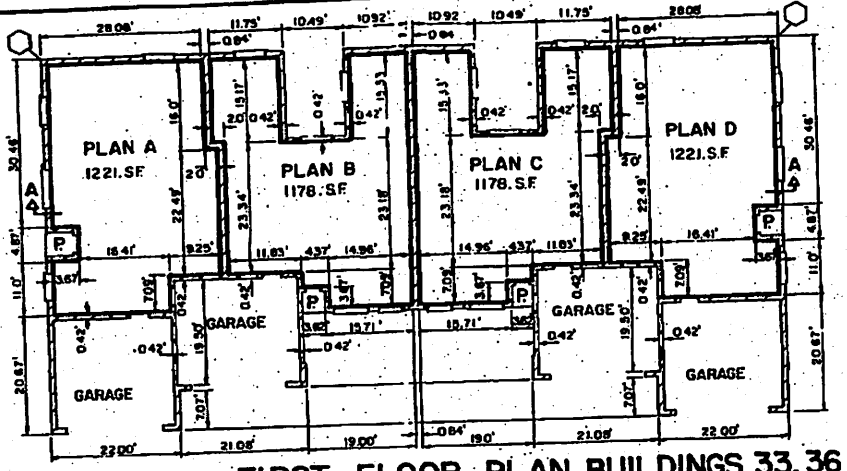


LINE 061001736

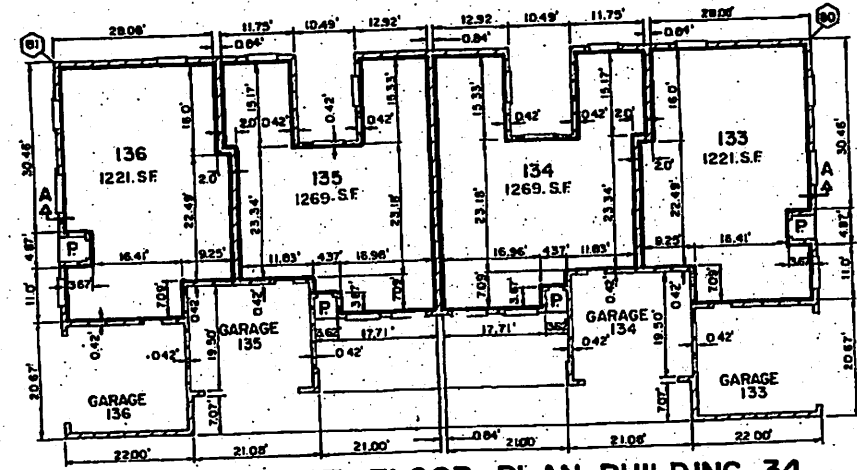

FIRST FLOOR PLAN BUILDINGS 33, 36



FIRST FLOOR PLAN BUILDING 34

-  - GENERAL COMMON ELEMENT
-  - LIMITS OF OWNERSHIP
-  - COORDINATE POINT.
- NOTE - ALL EXTERIOR AND INTERIOR BASEMENT WALLS ARE 0'0"
- ALL WALLS ARE AT RIGHT ANGLES TO EACH OTHER
- ALL EXTERIOR FIRST FLOOR WALLS ARE 0'7"
- P - PORCH, LIMITED COMMON ELEMENT
- GARAGE - LIMITED COMMON ELEMENT

NOTE - BUILDINGS 33, 34 AND 36 DO NOT HAVE BASEMENTS.

SCHEDULE OF UNIT NUMBERS

BLDG. N°	UNIT NUMBERS			
	PLAN A	PLAN B	PLAN C	PLAN D
33	132	131	130	129
36	144	143	142	141

LIB# 0610010737


MORAVIAN MEADOWS

AS-BUILT AUG 6, 1990


ROBERT SHARADA
REGISTERED LAND SURVEYOR
3704 KELLY ROAD
ST. CLEMENS, MICHIGAN
48043
PHONE - 480-6113

SCALE - 1/8" = 1'-0"

SHEET 31

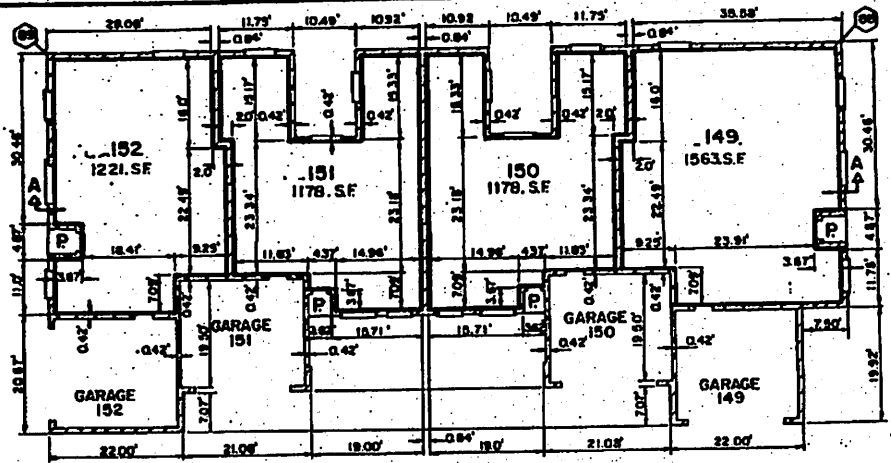

FIRST FLOOR PLAN

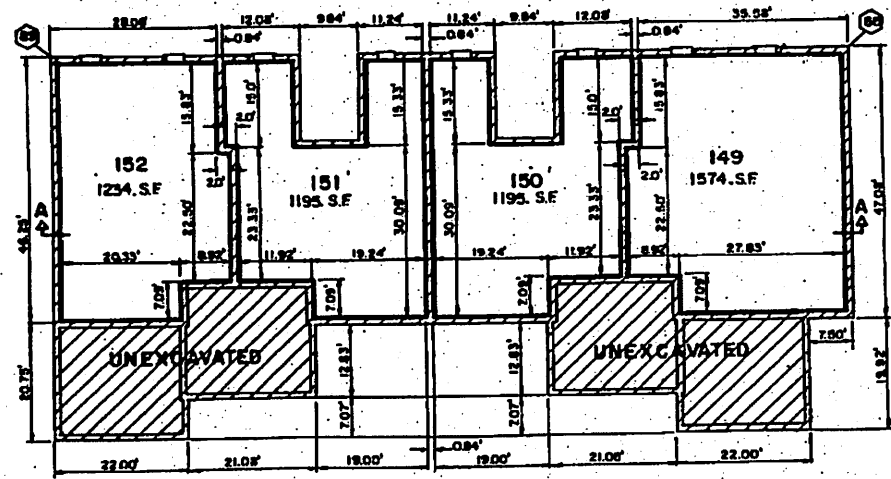

BASEMENT PLAN

BUILDING 38




MORAVIAN MEADOWS
 SCALE: 1/8" = 1'-0"
 0' 5' 10'

AS-BUILT AUG. 6, 1990
 ROBERT SHARAVA
 REGISTERED LAND SURVEYOR
 27014 KELLY ROAD
 SE CLEMENS, MICHIGAN
 48043
 PHONE-468-8123

SHEET 32

URN 06100P 738

LIBER 06100 PG 739

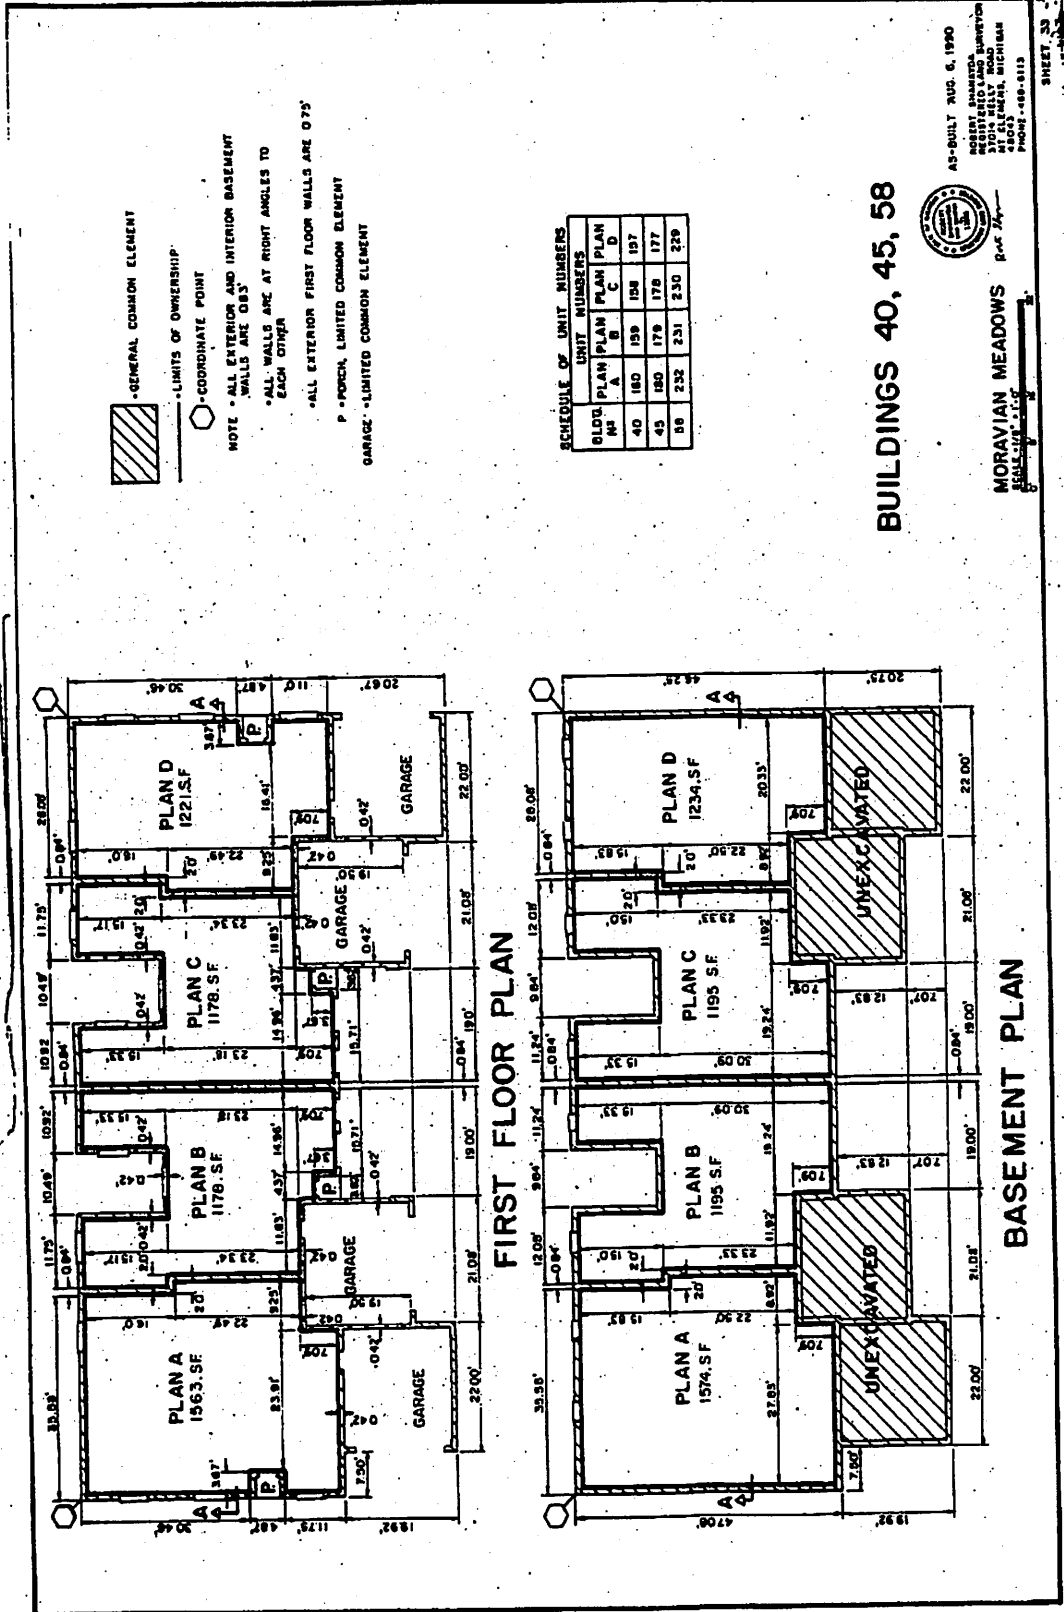

*GENERAL COMMON ELEMENT
 *LIMITS OF OWNERSHIP
 *COORDINATE POINT
 NOTE *ALL EXTERIOR AND INTERIOR BASEMENT WALLS ARE 08"
 *ALL WALLS ARE AT RIGHT ANGLES TO EACH OTHER
 *ALL EXTERIOR FIRST FLOOR WALLS ARE 075"
 P *POUCH, LIMITED COMMON ELEMENT GARAGE *LIMITED COMMON ELEMENT

SCHEDULE OF UNIT NUMBERS

BLDG.	PLAN	PLAN A	PLAN B	PLAN C	PLAN D
40	180	159	158	157	
45	180	179	178	177	
58	232	231	230	229	

BUILDINGS 40, 45, 58





MORAVIAN MEADOWS



SHEET 33

LIBER 06100PG740

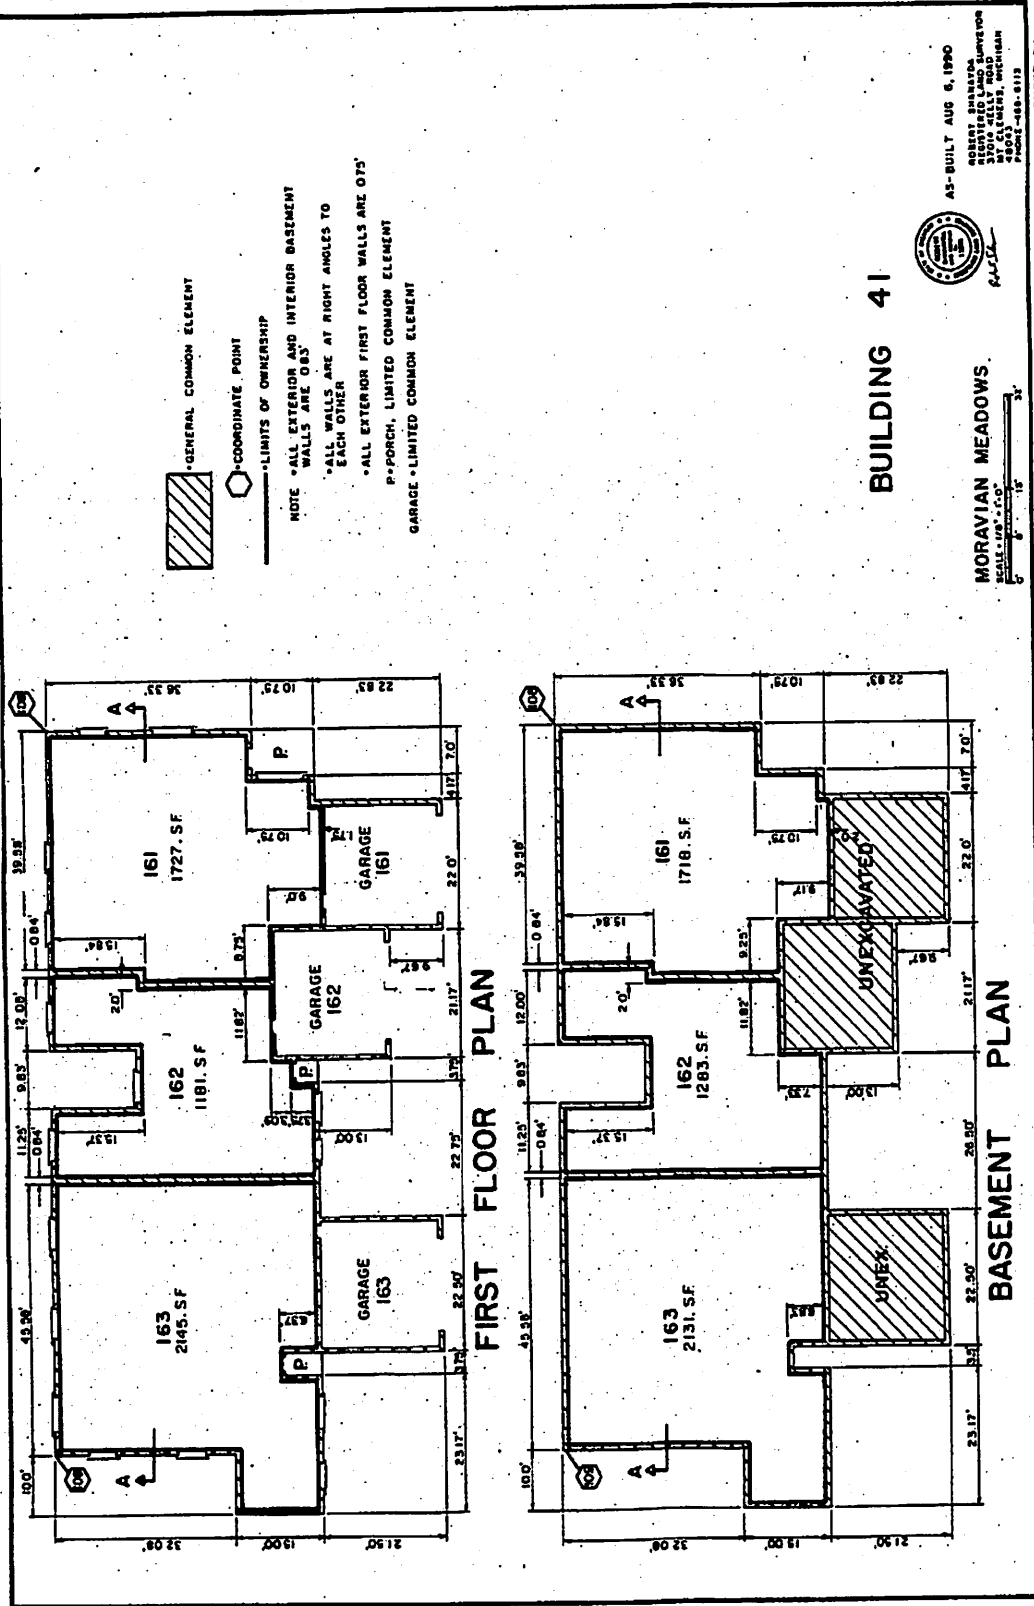

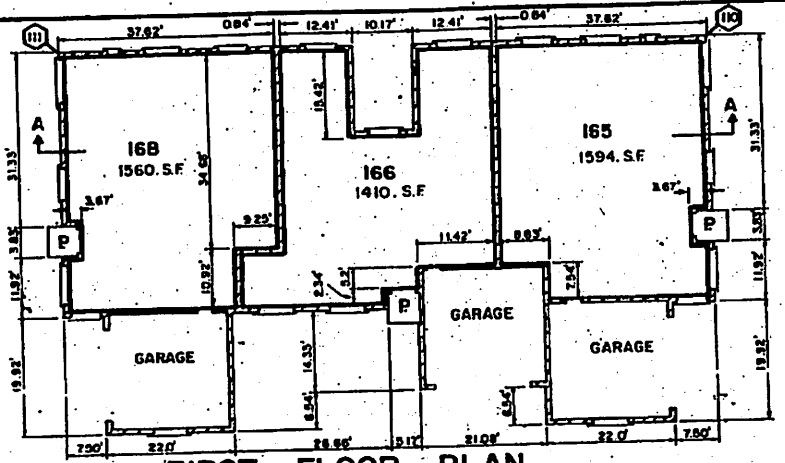



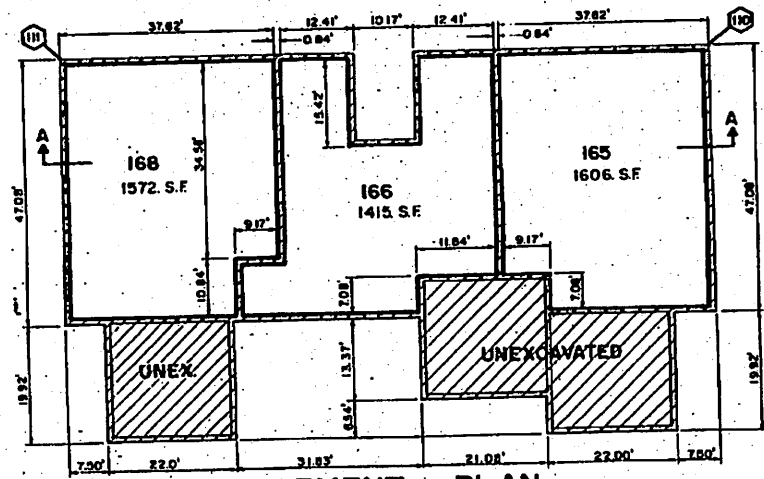

FIRST FLOOR PLAN



BASEMENT PLAN

-  GENERAL COMMON ELEMENT
-  COORDINATE POINT
-  LIMITS OF OWNERSHIP
- NOTE - ALL EXTERIOR AND INTERIOR BASEMENT WALLS ARE 0.83'
- ALL WALLS ARE AT RIGHT ANGLES TO EACH OTHER.
- ALL EXTERIOR FIRST FLOOR WALLS ARE 0.75'
- P - PORCH, LIMITED COMMON ELEMENT
- GARAGE - LIMITED COMMON ELEMENT

BUILDING 42

MORAVIAN MEADOWS
 SCALE: 1/8" = 1'-0"


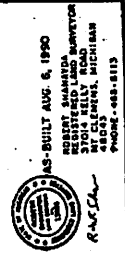


AS-BUILT AUG. 6, 1990
 ROBERT SHANAYDA
 REGISTERED LAND SURVEYOR
 37014 KELLY ROAD
 MT CLEMENS, MICHIGAN
 48043
 PHONE -480-8113

SHEET 35


LINE 061000741

LIBER 06100PG742



MORAVIAN MEADOWS
BUILDING 44

SHEET 38

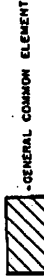

GENERAL COMMON ELEMENT

LIMITS OF OWNERSHIP


COORDINATE POINT

NOTE: ALL EXTERIOR AND INTERIOR BASEMENT WALLS ARE 0.83' EACH OTHER.


ALL EXTERIOR FIRST FLOOR WALLS ARE 0.75'

P - PORCH, LIMITED COMMON ELEMENT

GARAGE - LIMITED COMMON ELEMENT

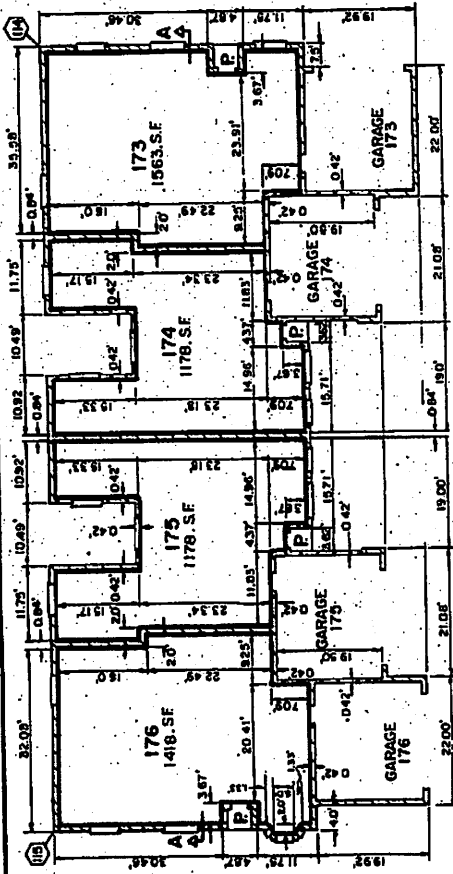

FIRST FLOOR PLAN

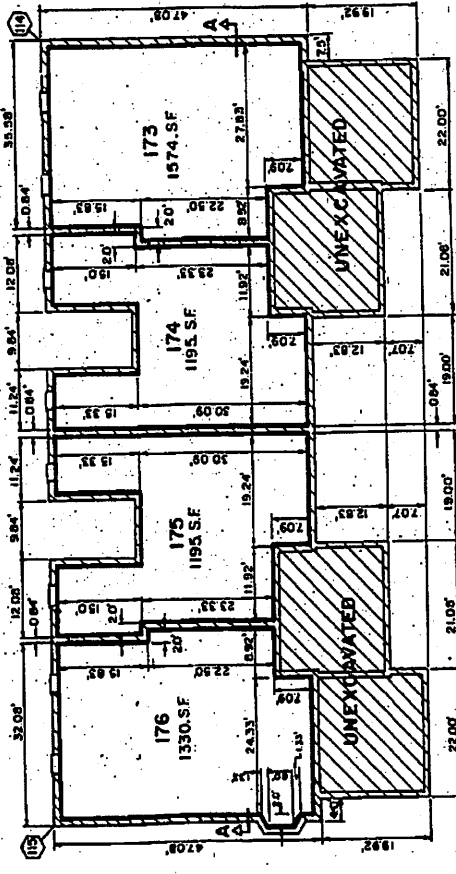

BASEMENT PLAN

BUILDING 44

LIBER 0610076743



GENERAL COMMON ELEMENT

LIMITS OF OWNERSHIP



COORDINATE POINT

NOTE • ALL EXTERIOR AND INTERIOR BASEMENT WALLS ARE 0.83" THICK
• ALL WALLS ARE AT RIGHT ANGLES TO EACH OTHER.

• ALL EXTERIOR FIRST FLOOR WALLS ARE 0.75" THICK

P • PORCH, LIMITED COMMON ELEMENT.

GARAGE • LIMITED COMMON ELEMENT.




AS-BUILT AUG. 6, 1990


BUILDING 46

MORAVIAN MEADOWS
RESUBDIVISION

SHEET 37

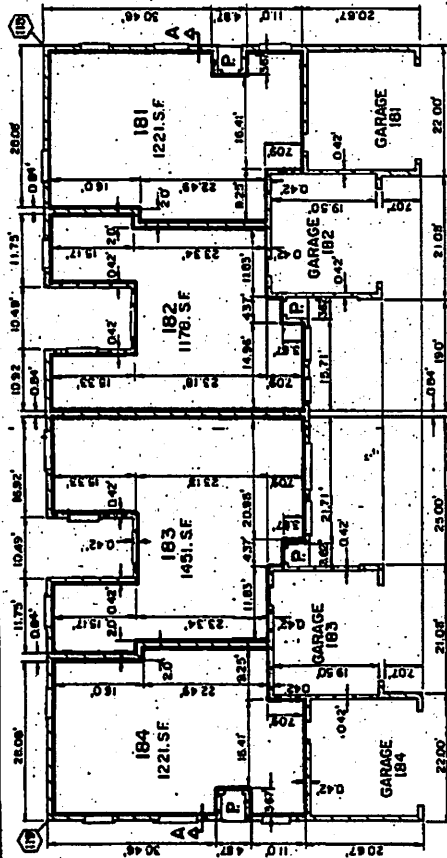

FIRST FLOOR PLAN

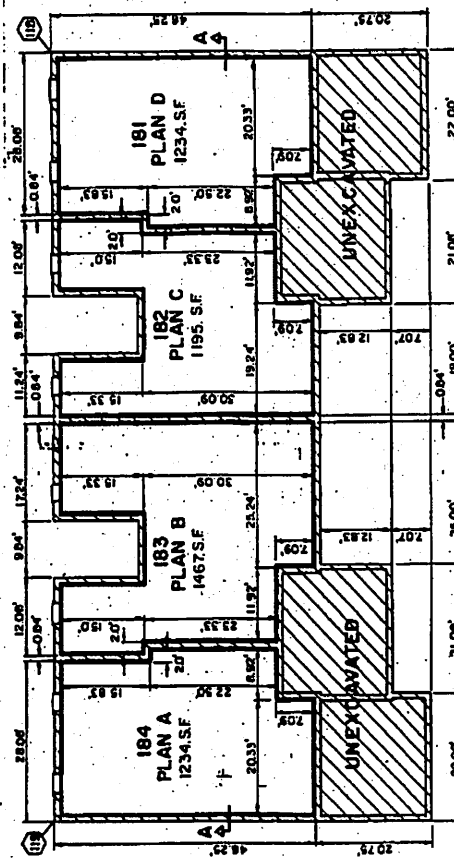

BASEMENT PLAN


LIBER 06100 PG 744

BUILDING S 48 AND 57



AS-BUILT AUG. 6, 1990

SHEET 30

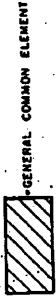

GENERAL COMMON ELEMENT



COORDINATE POINT

NOTE: ALL EXTERIOR AND INTERIOR BASEMENT WALLS ARE 0.83'

*ALL WALLS ARE AT RIGHT ANGLES TO EACH OTHER.

*ALL EXTERIOR FIRST FLOOR WALLS ARE 0.75'

P - PORCH, LIMITED COMMON ELEMENT


GARAGE - LIMITED COMMON ELEMENT

*YES - FOR CORNER UNITS ONLY, FRONT OR SIDE ENTRANCE TO GARAGE OPTIONAL, SEE SITE PLAN FOR GARAGE ENTRANCE


SCHEDULE OF UNIT NUMBERS

BLDG. NO.	PLAN A	PLAN B	PLAN C
48	192	180	185
57	228	226	225


MORAVIAN MEADOWS

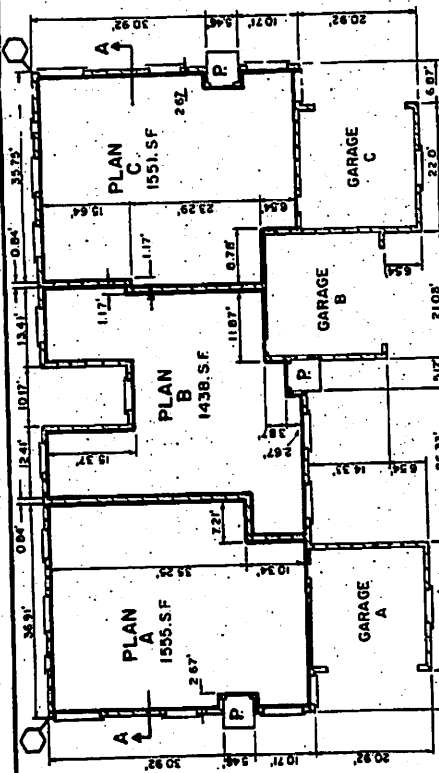


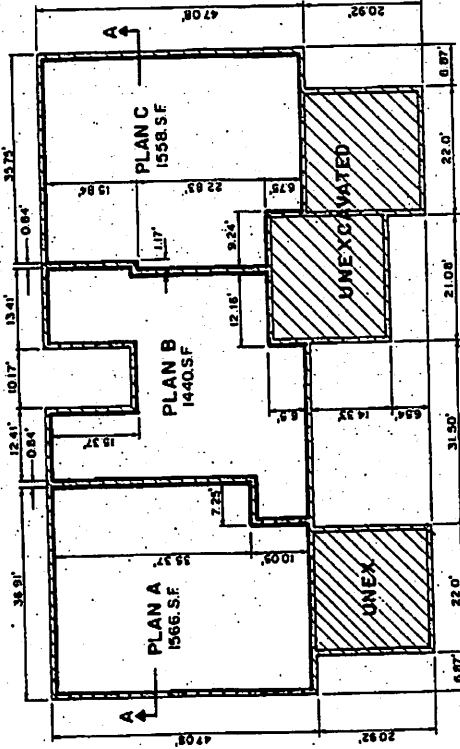

FIRST FLOOR PLAN

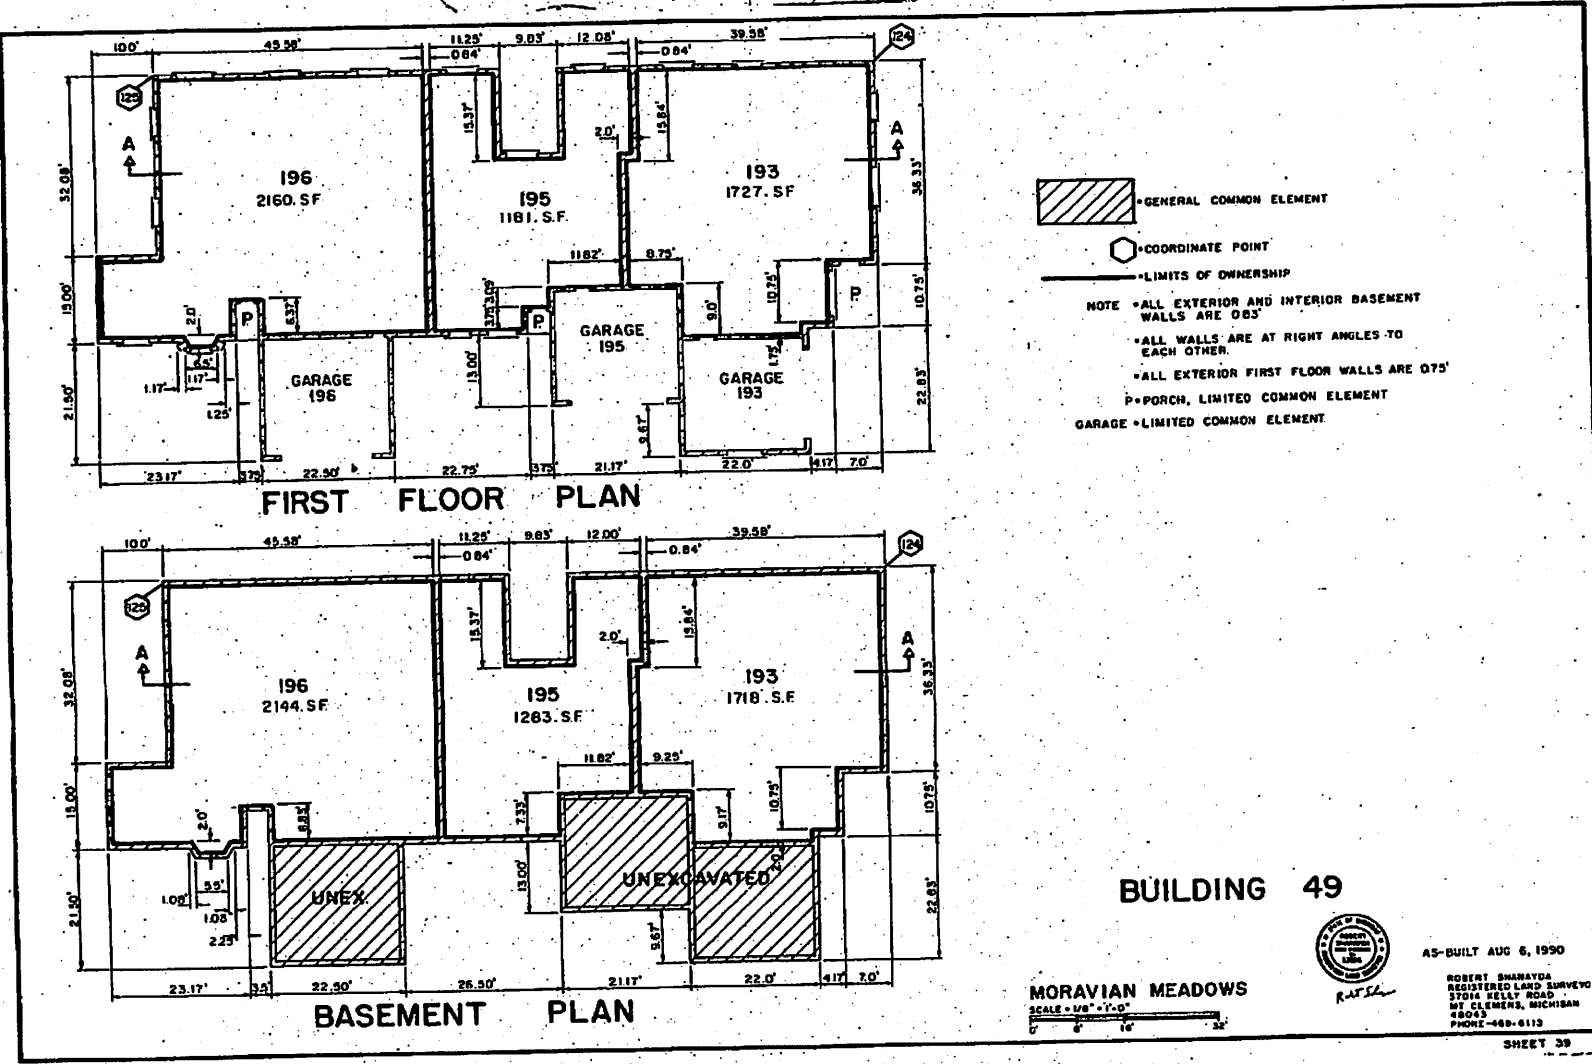

BASEMENT PLAN

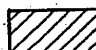

 GENERAL COMMON ELEMENT
 COORDINATE POINT
 LIMITS OF OWNERSHIP
 NOTE:

- ALL EXTERIOR AND INTERIOR BASEMENT WALLS ARE 06"
- ALL WALLS ARE AT RIGHT ANGLES TO EACH OTHER.
- ALL EXTERIOR FIRST FLOOR WALLS ARE 075"
- P=PORCH, LIMITED COMMON ELEMENT
- GARAGE=LIMITED COMMON ELEMENT

FIRST FLOOR PLAN

BASEMENT PLAN

BUILDING 49

URA 06100P745


MORAVIAN MEADOWS
 SCALE = 1/8" = 1'-0"





AS-BUILT AUG 6, 1990
 ROBERT SHAMATYA
 REGISTERED LAND SURVEYOR
 2014 SELLY ROAD
 MT CLEMENS, MICHIGAN
 48063
 PHONE-480-6113


SHEET 39

UBR 06100P746

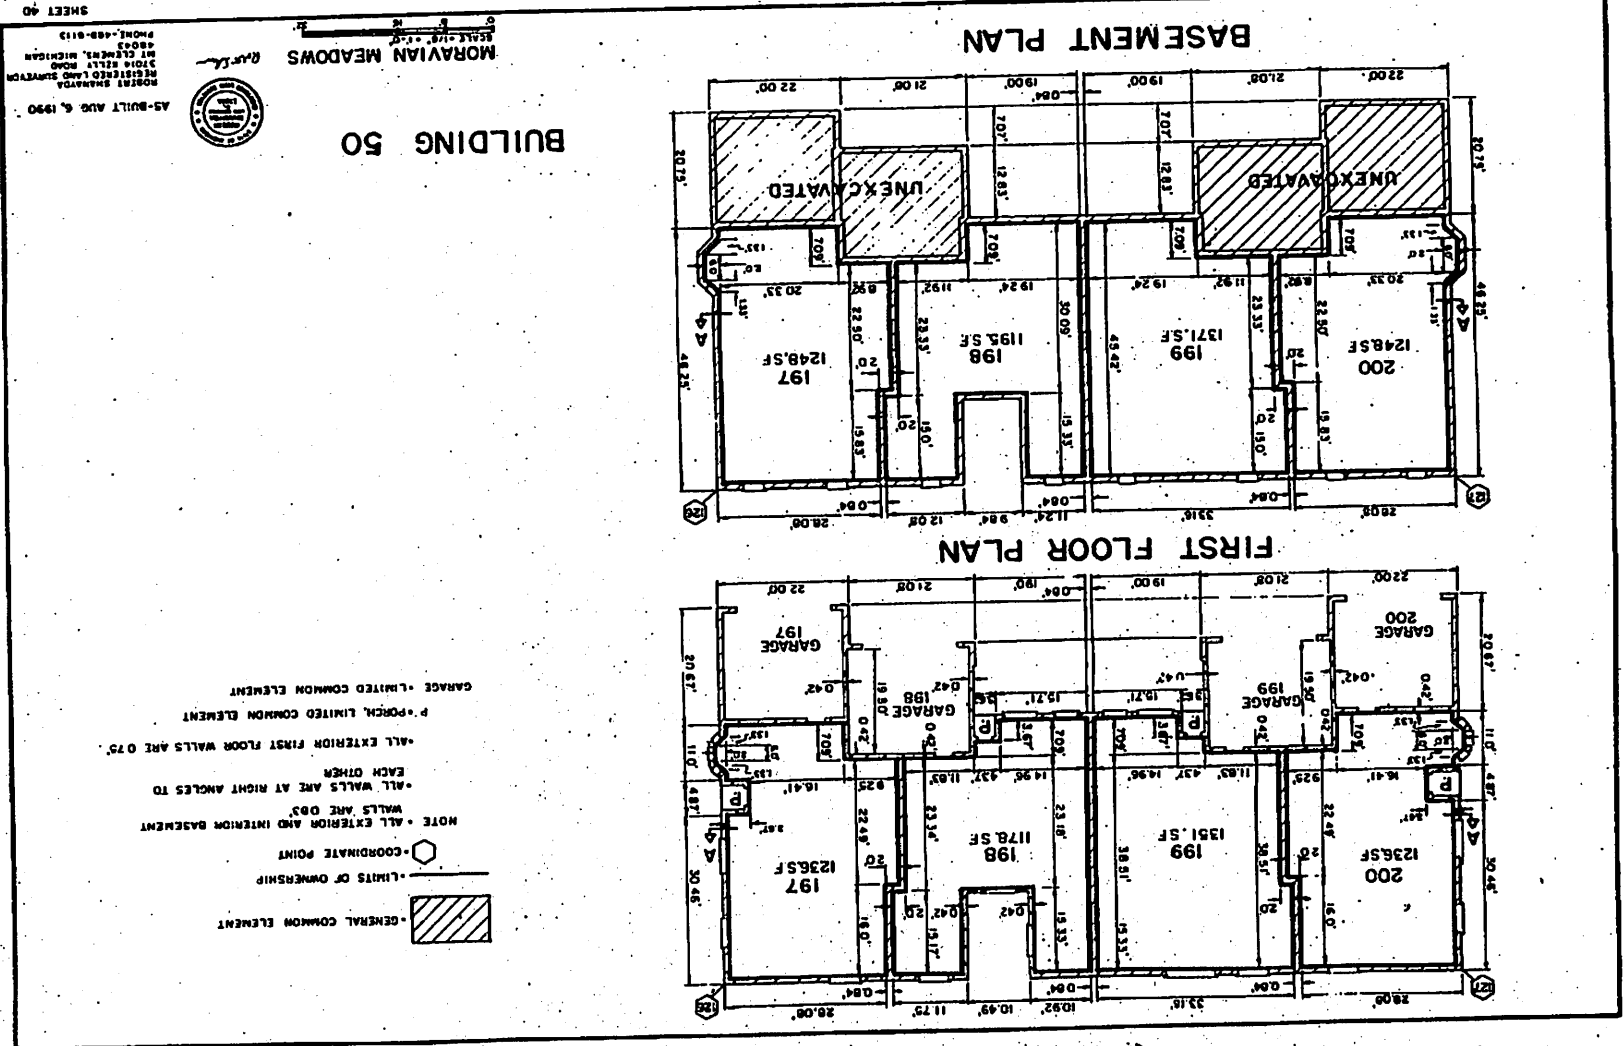

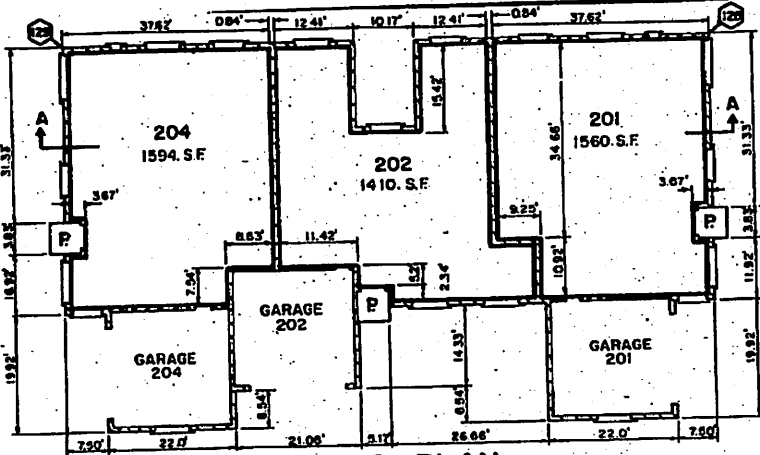

FIRST FLOOR PLAN

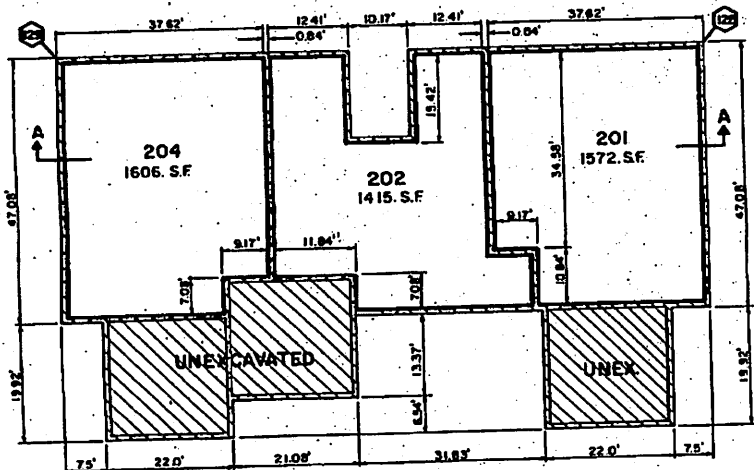

BASEMENT PLAN



GENERAL COMMON ELEMENT.

COORDINATE POINT.

LIMITS OF OWNERSHIP

NOTE - ALL EXTERIOR AND INTERIOR BASEMENT WALLS ARE 0.83'

- ALL WALLS ARE AT RIGHT ANGLES TO EACH OTHER.

- ALL EXTERIOR FIRST FLOOR WALLS ARE 0.75'

P - PORCH, LIMITED COMMON ELEMENT.

GARAGE - LIMITED COMMON ELEMENT.

NOTE - FOR CORNER UNITS ONLY, FRONT OR SIDE ENTRANCE TO GARAGE OPTIONAL, SEE SITE PLAN FOR GARAGE ENTRANCE.

BUILDING 51

UBA 061000747

MORAVIAN MEADOWS
 SCALE - 1/8" = 1'-0"
 0 5 10 30



AS-BUILT AUG. 6, 1990
 ROBERT SHANAYDA
 REGISTERED LAND SURVEYOR
 3704 KELLY ROAD
 MT CLEMENS, MICHIGAN
 48043
 PHONE - 468-8113

SHEET 41

LIBER 06100 PG 748



GENERAL COMMON ELEMENT

LIMITS OF OWNERSHIP

COORDINATE POINT

NOTE: ALL EXTERIOR AND INTERIOR BASEMENT WALLS ARE 0'0"

ALL WALLS ARE AT RIGHT ANGLES TO EACH OTHER.

ALL EXTERIOR FIRST FLOOR WALLS ARE 0'75"

P - PORCH, LIMITED COMMON ELEMENT

GARAGE - LIMITED COMMON ELEMENT


NOTE: BUILDINGS 52 AND 53 DO NOT HAVE BASEMENTS.




MORAVIAN MEADOWS



SHEET 42

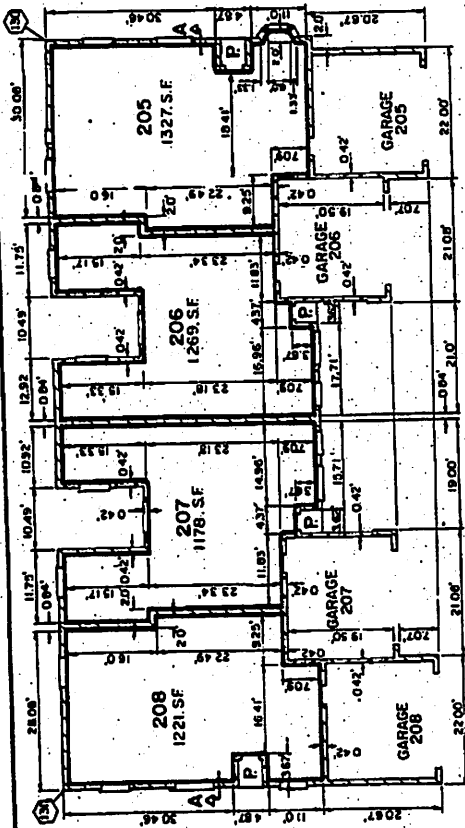

FIRST FLOOR PLAN BUILDING 52

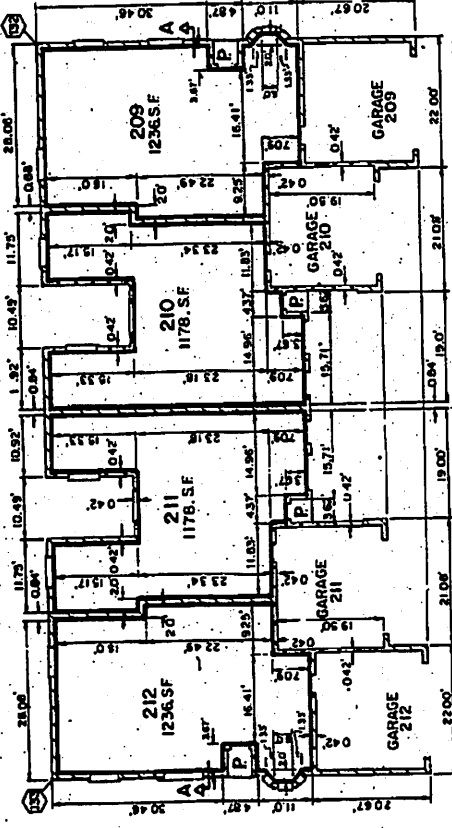

FIRST FLOOR PLAN BUILDING 53

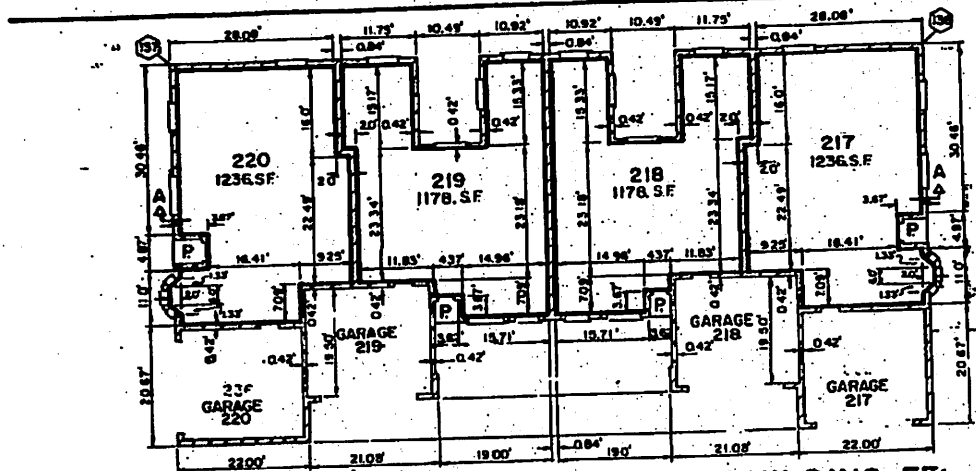

FIRST FLOOR PLAN BUILDING 55



-GENERAL COMMON ELEMENT

-LIMITS OF OWNERSHIP



-COORDINATE POINT.

NOTE - ALL EXTERIOR AND INTERIOR BASEMENT WALLS ARE 0.83'

- ALL WALLS ARE AT RIGHT ANGLES TO EACH OTHER.

- ALL EXTERIOR FIRST FLOOR WALLS ARE 0.75'

P - PORCH, LIMITED COMMON ELEMENT

GARAGE - LIMITED COMMON ELEMENT.

LINE 06100R749




AS-BUILT ADR. 8, 1990

MORAVIAN MEADOWS
SCALE - 1/8" = 1'-0"

ROBERT SHRAYDA
REGISTERED LAND SURVEYOR
3104 KELLY ROAD
MC CLENS, MICHIGAN
48043
PHONE - 408-0113

SHEET 43

LIBER 06100 PG 750

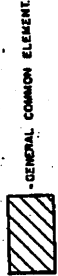

GENERAL COMMON ELEMENT

LIMITS OF OWNERSHIP

COORDINATE POINT

NOTE - ALL EXTERIOR AND INTERIOR BASEMENT WALLS ARE 0'8"

-ALL WALLS ARE AT RIGHT ANGLES TO EACH OTHER.

-ALL EXTERIOR FIRST FLOOR WALLS ARE 0'7"

P - PORCH, LIMITED COMMON ELEMENT


GARAGE - LIMITED COMMON ELEMENT




AS-BUILT AUG 6, 1990
PHONE -482-8113

MORAVIAN MEADOWS
SCALE: 1/8" = 1'-0"


SHEET 44

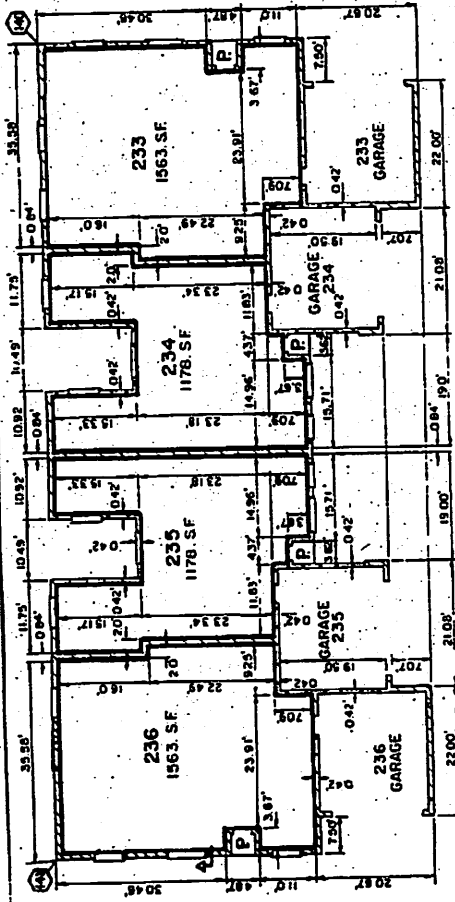


FIRST FLOOR PLAN BUILDING 59

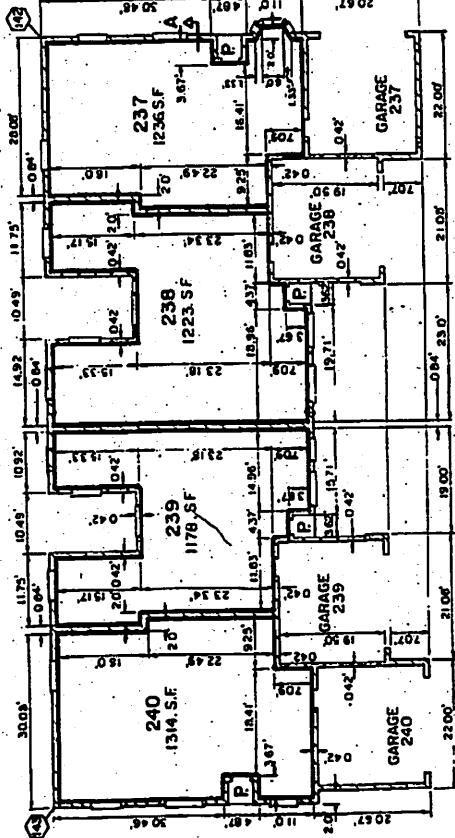


FIRST FLOOR PLAN BUILDING 60

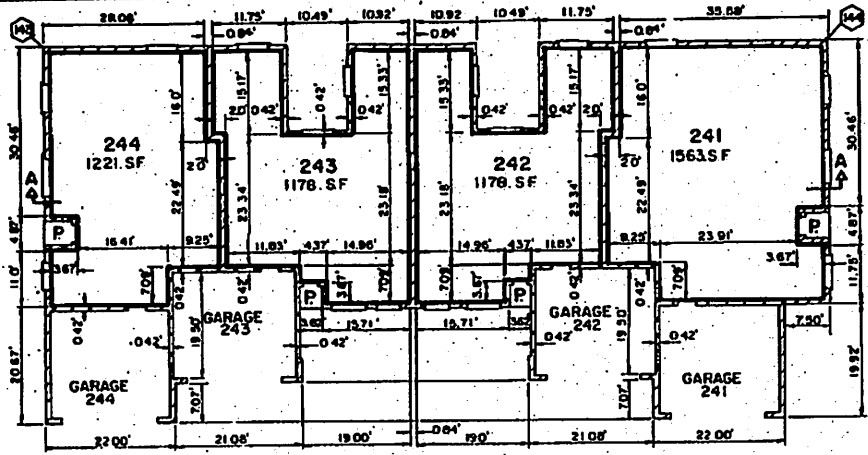

FIRST FLOOR PLAN 61

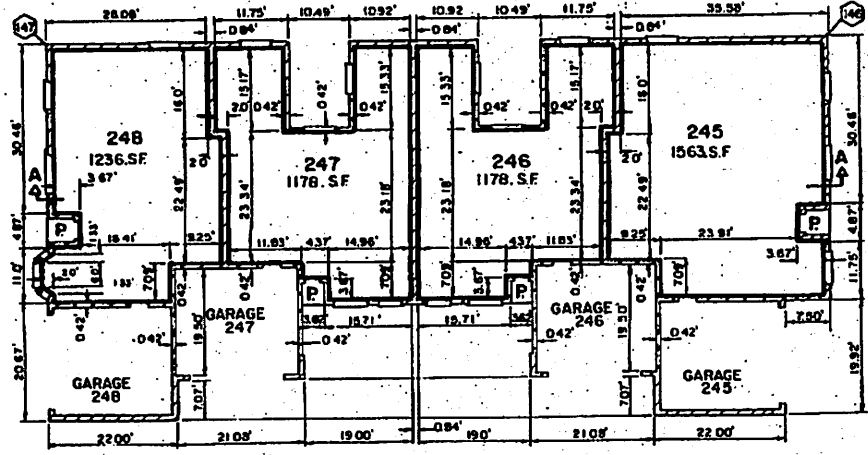

FIRST FLOOR PLAN 62

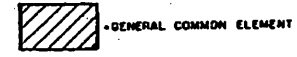

GENERAL COMMON ELEMENT



LIMITS OF OWNERSHIP



COORDINATE POINT

NOTE - ALL EXTERIOR AND INTERIOR BASEMENT WALLS ARE 0.63'

- ALL WALLS ARE AT RIGHT ANGLES TO EACH OTHER.

- ALL EXTERIOR FIRST FLOOR WALLS ARE 0.75'

P - PORCH, LIMITED COMMON ELEMENT

GARAGE - LIMITED COMMON ELEMENT

LIB# 061007751




AS-BUILT AUG. 6, 1990
 ROBERT SKURATKA
 REGISTERED LAND SURVEYOR
 3704 KELLY ROAD
 MT CLEMENS, MICHIGAN
 48043
 PHONE -482-6113

MORAVIAN MEADOWS
 SCALE - 1/8" = 1'-0"

SHEET 45

LIBER 06100752

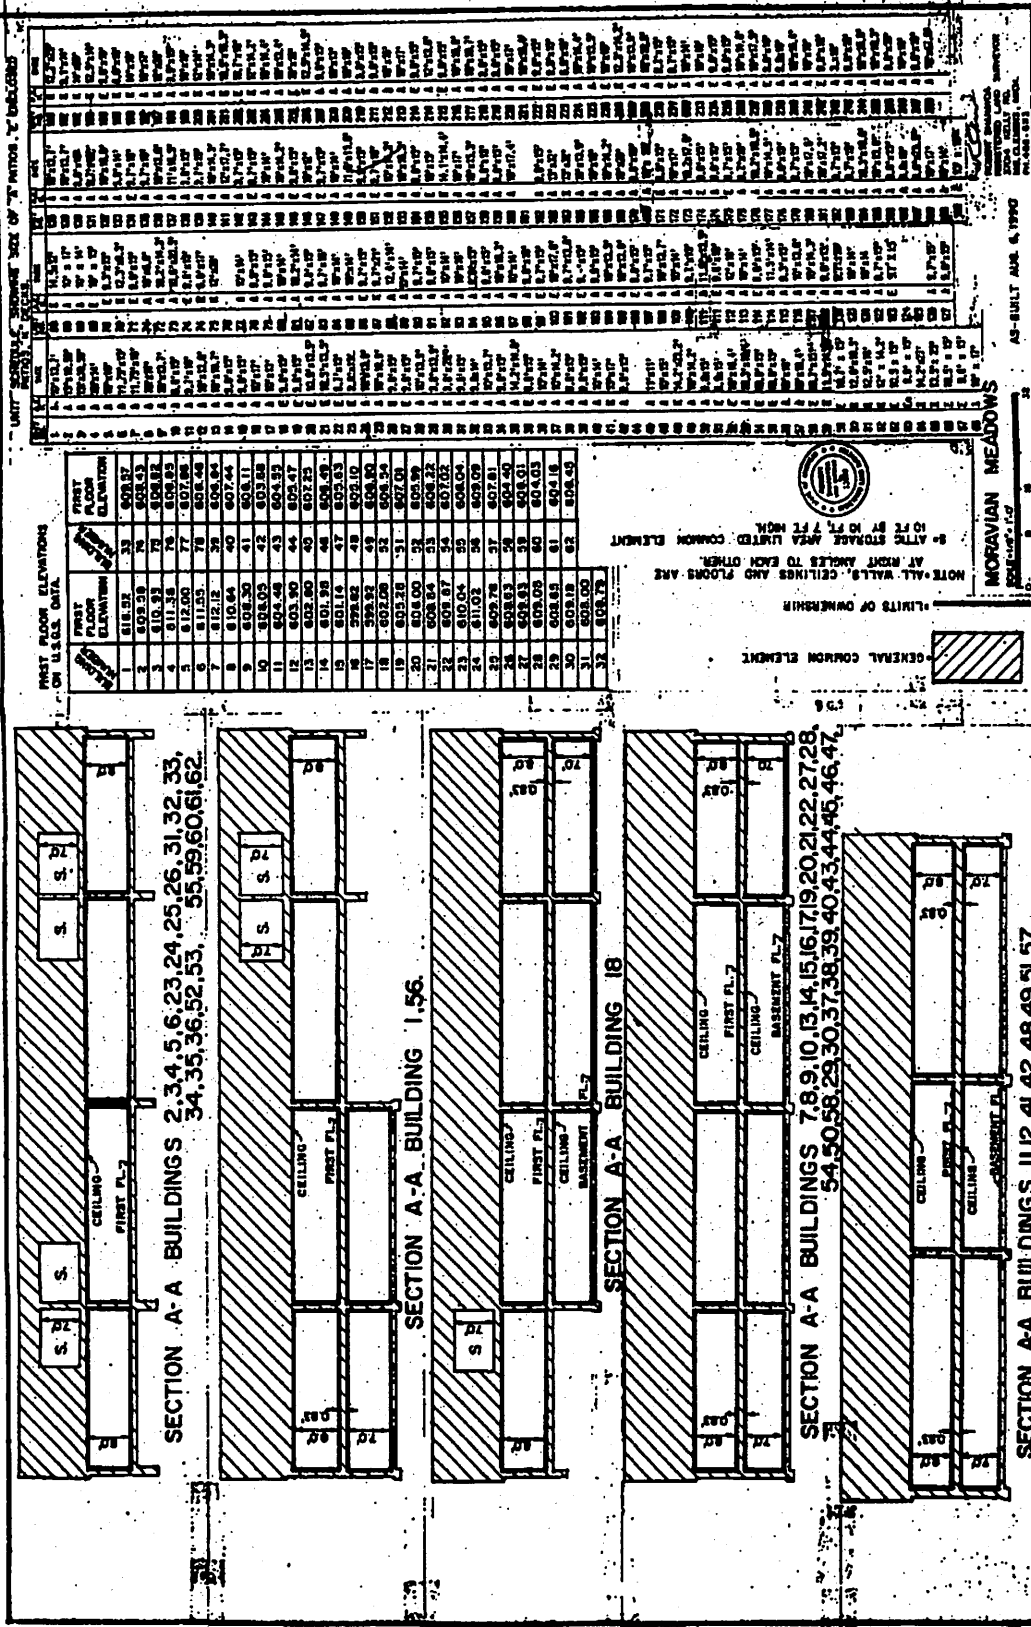

FIRST FLOOR ELEVATIONS ON U.S.S. DATA

NO.	FIRST FLOOR ELEVATION	FIRST FLOOR ELEVATION
1	618.92	609.12
2	609.98	608.43
3	610.33	608.12
4	611.38	608.83
5	612.00	607.98
6	611.05	608.48
7	612.12	608.84
8	610.64	607.64
9	608.30	606.11
10	604.05	603.88
11	604.48	604.53
12	603.90	603.47
13	602.80	602.25
14	601.95	600.49
15	601.16	600.10
16	598.62	599.10
17	598.93	598.83
18	602.08	600.54
19	603.28	601.01
20	604.00	600.89
21	608.84	606.72
22	609.87	608.04
23	610.04	608.04
24	610.02	607.91
25	609.78	607.40
26	608.83	606.40
27	608.83	606.40
28	608.08	604.03
29	608.83	604.18
30	608.19	604.48
31	608.00	604.48
32	608.78	604.48

NOTES: ALL WALLS, CEILING AND FLOORS ARE AT RIGHT ANGLES TO EACH OTHER.
 - LIMITS OF OWNERSHIP

GENERAL COMMON ELEMENT

MORAVIAN MEADOWS

AS-BUILT AUG. 6, 1990
 SHEET 40

ONLY AS GOOD AS THE ORIGINAL

LIBER 06100 PG 753



GENERAL COMMON ELEMENT

LIMITS OF OWNERSHIP

COORDINATE POINT

NOTE - ALL EXTERIOR AND INTERIOR BASEMENT WALLS ARE 0.75'

ALL WALLS ARE AT RIGHT ANGLES TO EACH OTHER.

ALL EXTERIOR FIRST FLOOR WALLS ARE 0.75'

P - PORCH, LIMITED COMMON ELEMENT

GARAGE - LIMITED COMMON ELEMENT

NOTE - FOR CORNER UNITS ONLY: FRONT OR SIDE WALLS ARE TO GARAGE ENTRANCE. SEE SITE PLAN FOR GARAGE ENTRANCE.



AS BUILT AUG. 6, 1990


MORAVIAN MEADOWS
REGISTERED LAND SURVEYOR
PHONE: 482-8113

BUILDING 54


MORAVIAN MEADOWS

DATE: 8/1/90

SCALE: 1/8" = 1'-0"

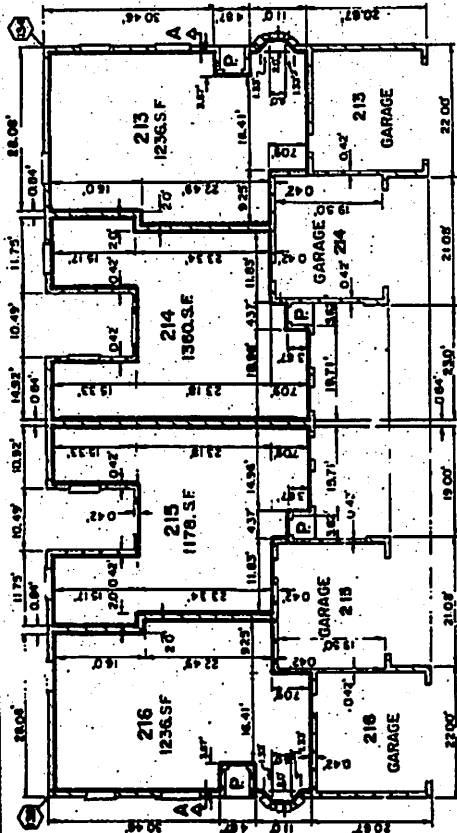

FIRST FLOOR PLAN

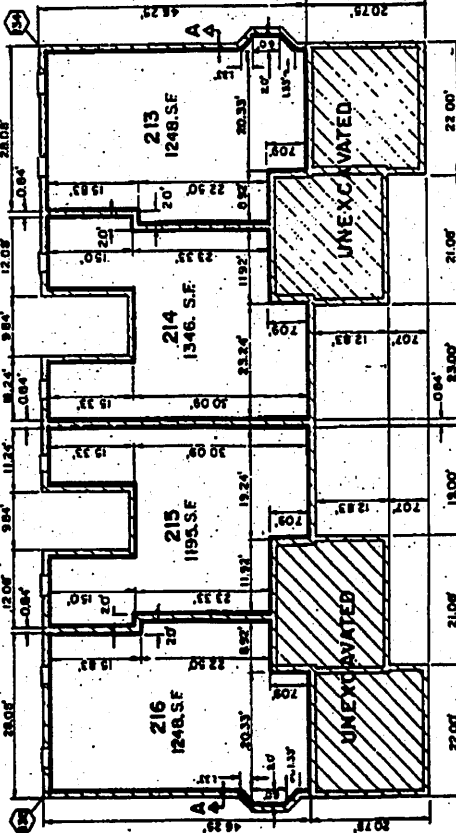

BASEMENT PLAN

**RESTATED ARTICLES OF INCORPORATION
MORAVIAN MEADOWS ASSOCIATION**

MICHIGAN DEPARTMENT OF COMMERCE — CORPORATION AND SECURITIES BUREAU	
<p>(FOR BUREAU USE ONLY)</p> <p>FILED</p> <p>DEC 18 1989</p> <p>Administrator MICHIGAN DEPT OF COMMERCE Corporation & Securities Bureau</p>	Date Received
	NOV 13 1989
	DEC 18 1989

CERTIFICATE OF AMENDMENT TO THE ARTICLES OF INCORPORATION
For use by Domestic Corporations

(Please read instructions and Paperwork Reduction Act notice on last page)

Pursuant to the provisions of Act 284, Public Acts of 1972, as amended (profit corporations), or Act 162, Public Acts of 1982 (nonprofit corporations), the undersigned corporation executes the following Certificate:

1. The present name of the corporation is:	MORAVIAN MEADOWS	ASSOCIATION							
2. The corporation identification number (CiD) assigned by the Bureau is:	<table border="1" style="display: inline-table;"> <tr> <td>7</td><td>1</td><td>2</td><td>-</td><td>8</td><td>5</td><td>3</td> </tr> </table>		7	1	2	-	8	5	3
7	1	2	-	8	5	3			
3. The location of its registered office is:	<u>20501 Majestic Blvd., Mt. Clemens</u> (City), Michigan <u>48045</u> (ZIP Code)								

4. Article XI of the Articles of Incorporation is hereby amended to read as follows:

The addition of the following Section 15.

A Volunteer Director shall not be personally liable to the corporation or its members for monetary damages for breach of fiduciary duty as a Director, except for liability:

- a. For any breach of the Director's duty of loyalty to the corporation or its members;
- b. For acts or omissions not in good faith or that involve intentional misconduct or knowing violation of law;
- c. For violation of Section 551(1) of the Michigan Business Corporation Act;
- d. For any transaction from which the Director derived an improper personal benefit;
- e. For any acts or omissions occurring before January 1, 1988; and
- f. For an act or omission that is grossly negligent.

30



5. COMPLETE SECTION (a) IF THE AMENDMENT WAS ADOPTED BY THE UNANIMOUS CONSENT OF THE INCORPORATOR(S) BEFORE THE FIRST MEETING OF THE BOARD OF DIRECTORS OR TRUSTEES; OTHERWISE, COMPLETE SECTION (b)

a. The foregoing amendment to the Articles of Incorporation was duly adopted on the _____ day of _____, 19____, in accordance with the provisions of the Act by the unanimous consent of the incorporator(s) before the first meeting of the board of directors or trustees.

Signed this _____ day of _____, 19____

(Signatures of all incorporators; type or print name under each signature)

b. The foregoing amendment to the Articles of Incorporation was duly adopted on the 18th day of September, 1989. The amendment: (check one of the following)

was duly adopted in accordance with Section 611(2) of the Act by the vote of the shareholders if a profit corporation, or by the vote of the shareholders or members if a nonprofit corporation, or by the vote of the directors if a nonprofit corporation organized on a nonstock directorship basis. The necessary votes were cast in favor of the amendment.

was duly adopted by the written consent of all the directors pursuant to Section 525 of the Act and the corporation is a nonprofit corporation organized on a nonstock directorship basis.

was duly adopted by the written consent of the shareholders or members having not less than the minimum number of votes required by statute in accordance with Section 407(1) and (2) of the Act. Written notice to shareholders or members who have not consented in writing has been given. (Note: Written consent by less than all of the shareholders or members is permitted only if such provision appears in the Articles of Incorporation.)

was duly adopted by the written consent of all the shareholders or members entitled to vote in accordance with Section 407(3) of the Act.

Signed this 30th day of October, 1989

By William J. McComsey
(Signature)

William J. McComsey, President
(Type or Print Name and Title)

DOCUMENT WILL BE RETURNED TO NAME AND MAILING ADDRESS INDICATED IN THE BOX BELOW. Include name, street and number (or P.O. box), city, state and ZIP code.

Name of person or organization remitting fees:

LEO M. KISTNER
ATTORNEY AT LAW
3705 HAWK
WARREN, MI 48093

Preparer's name and business telephone number:

LEO M. KISTNER

(313) 756-0900

INFORMATION AND INSTRUCTIONS

1. This form is issued under the authority of Act 234, P.A. of 1972, as amended, and Act 162, P.A. of 1982. The amendment cannot be filed until this form, or a comparable document, is submitted.
2. Submit one original copy of this document. Upon filing, a microfilm copy will be prepared for the records of the Corporation and Securities Bureau. The original copy will be returned to the address appearing in the box above as evidence of filing.
Since this document must be microfilmed, it is important that the filing be legible. Documents with poor black and white contrast, or otherwise illegible, will be rejected.
3. This document is to be used pursuant to the provisions of section 631 of the Act for the purpose of amending the articles of incorporation of a domestic profit or nonprofit corporation. A nonprofit corporation is one incorporated to carry out any lawful purpose or purposes not involving pecuniary profit or gain for its directors, officers, shareholders, or members. A nonprofit corporation organized on a nonstock directorship basis, as authorized by Section 302 of the Act, may or may not have members, but if it has members, the members are not entitled to vote.
4. Item 2 — Enter the identification number previously assigned by the Bureau. If this number is unknown, leave it blank.
5. Item 4 — The entire article being amended must be set forth in its entirety. However, if the article being amended is divided into separately identifiable sections, only the sections being amended need be included.
6. This document is effective on the date approved and filed by the Bureau. A later effective date, no more than 90 days after the date of delivery, may be stated.
7. If the amendment is adopted before the first meeting of the board of directors, item 5(a) must be completed and signed in ink by all of the incorporators. If the amendment is otherwise adopted, item 5(b) must be completed and signed in ink by the president, vice-president, chairperson, or vice-chairperson of the corporation.

8. FEES: Filing fee (Make remittance payable to State of Michigan)..... \$10.00
 Franchise fee for profit corporations (payable only if authorized capital stock has increased) —
 ½ mill (.0005) on each dollar of increase over highest previous authorized capital stock.

9. Mail form and fee to:
 Michigan Department of Commerce
 Corporation and Securities Bureau
 Corporation Division
 P.O. Box 30054
 Lansing, MI 48909
 Telephone: (517) 373-0493

LAW OFFICES
OF
KISTNER, SCHIENKE, STAUGAARD, DETTLOFF, HILL,
KISTNER, TROYANOVICH & TROYANOVICH

LEO M. KISTNER, P.C.
FREDERICK H. SCHIENKE, P.C.
WILLIAM L. STAUGAARD
CARY R. DETTLOFF

AN ASSOCIATION OF INDIVIDUAL ATTORNEYS AND PROFESSIONAL CORPORATIONS

27007 HOOVER ROAD
WARREN, MICHIGAN 48093
313 756-0900

K-YE A. HILL
MARK S. KISTNER, P.C.
MICHAEL C. TROYANOVICH, P.C.
CYNTHIA KISTNER TROYANOVICH, P.C.

December 14, 1989

FILED

DEC 18 1989

DEC 18 1989

Ms. Frances Cox
Document Examiner
Corporation & Securities Bureau
Corporation Division
P. O. Box 30054
Lansing, MI 48909

Administrator
MICHIGAN DEPT OF COMMERCE
Corporation & Securities Bureau

RE: Moravian Meadows Association 712-853

Dear Ms. Cox:

Pursuant to your letter of November 29, 1989, we are herewith enclosing a change of both registered office and registered agent for the above-named corporation.

Please use this letter as your authority to insert in paragraph 3c the name of the present resident agent.

Also enclosed is a certificate of amendment to Articles of Incorporation. We ask that it be filed as we state that the provision does substantially conform with the act and request it be filed.

Yours truly,



Leo M. Kistner

LMK/js

Enclosure

**CERTIFICATE OF AMENDMENT TO THE
ARTICLES OF INCORPORATION
MORAVIAN MEADOWS ASSOCIATION**

LARA Corporations Online Filing System
Department of Licensing and Regulatory Affairs

Form Revision Date 07/2016

CERTIFICATE OF AMENDMENT TO THE ARTICLES OF INCORPORATION
For use by DOMESTIC NONPROFIT CORPORATION

Pursuant to the provisions of Act 162, Public Acts of 1982, the undersigned corporation executes the following Certificate:

The identification number assigned by the Bureau is:

The name of the corporation is:

The Articles of Incorporation is hereby amended to read as follows:

ARTICLE II

The purpose or purposes for which the corporation is formed are:

The purposes for which the Corporation is organized are:

1. Management and Administration. To manage and administer the affairs of and maintenance of Moravian Meadows (the "Condominium") and the Common Elements thereof, all to the extent set forth in the Condominium Documents for the Condominium.
2. Collecting Assessments. To collect assessments from the members of the corporation and to use the proceeds thereof for the purposes of the corporation.
3. Insurance. To carry insurance and collect and allocate the proceeds thereof.
4. Rebuild Improvements. To rebuild improvements after casualty, subject to the terms of the Condominium Documents.
5. Contract and Employ Persons. To contract for and employ persons, firms, corporations or other agents to assist in the management, operation, maintenance and administration of the Condominium.
6. Real or Personal Property. To acquire, maintain and improve, and to buy, operate, manage, sell, convey, assign, mortgage or lease any real or personal property (including any Unit in the Condominium and any easements, rights of way and licenses) on behalf of the corporation in furtherance of any of the purposes of the corporation.
7. Borrow Money. To borrow money and issue evidences of indebtedness in furtherance of any and all of the purposes of the business of the Corporation, and to secure the same by mortgage, pledge, or other lien on property owned by the Corporation; provided, however, that any such action shall also be approved by affirmative vote of more than 60% of all members entitled to vote, except in the case of financing or refinancing of a Unit acquired through foreclosure of the statutory lien for unpaid assessments, which shall require no such approval.
8. Assign Right to Future Income. To assign its right to future income, including the right to receive member assessment payments.
9. Rules and Regulations. To make rules and regulations in accordance with Article VI, Section 11 of the Condominium Bylaws.
10. Committees. To establish such committees as it deems necessary, convenient or desirable and to appoint persons thereto for the purpose of implementing the administration of the Condominium and to delegate to such committees, or any specific Officers or Directors of the Corporation any functions or responsibilities which are not by law or the Condominium Documents required to be performed by the Board.
11. Enforce Documents. To enforce the provisions of the Condominium Documents. 12. Administrator. To do anything required of or permitted to the Corporation as administrator of the Condominium under the Condominium Documents. 13. General. In general, to enter into any kind of activity, to make and perform any contract and to exercise all powers necessary, incidental or convenient to the administration, management, repair, replacement and operation of the Condominium and the Corporation.

Article III

The Corporation is formed upon basis.

If formed on a stock basis, the total number of shares the corporation has authority to issue is

The corporation is to be financed under the following general plan:

The Corporation is formed on a basis.

Use the space below for additional Articles or for continuation of previous Articles. Please identify any Article being continued or added.

ARTICLE IX
CLAIMS AGAINST VOLUNTEERS; ASSUMPTION OF VOLUNTEER LIABILITY BY THE CORPORATION

1. CLAIMS AGAINST VOLUNTEERS. UNDER ALL CIRCUMSTANCES EXCEPT THOSE LISTED IMMEDIATELY BELOW, NO PERSON OR ENTITY SHALL BRING OR MAINTAIN A CLAIM FOR MONETARY DAMAGES AGAINST A VOLUNTEER DIRECTOR OR VOLUNTEER OFFICER OF THE CORPORATION FOR A VOLUNTEER DIRECTOR'S OR VOLUNTEER OFFICER'S ACTS OR OMISSIONS. ANY SUCH CLAIM SHALL BE BROUGHT AND MAINTAINED AGAINST THE CORPORATION. THIS PROVISION CANNOT ELIMINATE LIABILITY FOR:

(A) THE AMOUNT OF A FINANCIAL BENEFIT RECEIVED BY A DIRECTOR OR VOLUNTEER OFFICER TO WHICH HE OR SHE IS NOT ENTITLED;

(B) INTENTIONAL INFLICTION OF HARM ON THE CORPORATION, ITS SHAREHOLDERS, OR MEMBERS;

(C) A VIOLATION OF SECTION 551;

(D) AN INTENTIONAL CRIMINAL ACT;

(E) A LIABILITY IMPOSED UNDER SECTION 497(A).

2. ASSUMPTION OF VOLUNTEER LIABILITY. THE CORPORATION SHALL ASSUME, PAY FOR, AND UNDERTAKE ALL OBLIGATIONS AND LIABILITY FOR ANY AND ALL ACTS OR OMISSIONS OF ITS VOLUNTEER DIRECTORS, VOLUNTEER OFFICERS, OR OTHER VOLUNTEERS, IF ALL OF THE FOLLOWING ARE MET:

(A) THE VOLUNTEER WAS ACTING OR REASONABLY BELIEVED HE OR SHE WAS ACTING WITHIN THE SCOPE OF HIS OR HER AUTHORITY.

(B) THE VOLUNTEER WAS ACTING IN GOOD FAITH.

(C) THE VOLUNTEER'S CONDUCT DID NOT AMOUNT TO GROSS NEGLIGENCE OR WILLFUL AND WANTON MISCONDUCT.

(D) THE VOLUNTEER'S CONDUCT WAS NOT AN INTENTIONAL TORT.

(E) THE VOLUNTEER'S CONDUCT WAS NOT A TORT ARISING OUT OF THE OWNERSHIP, MAINTENANCE, OR USE OF A MOTOR VEHICLE FOR WHICH TORT LIABILITY MAY BE IMPOSED AS PROVIDED IN SECTION 3135 OF THE INSURANCE CODE OF 1956, ACT NO. 218 OF THE PUBLIC ACTS OF 1956, BEING SECTION 500.3135 OF THE MICHIGAN COMPILED LAWS. ARTICLE X INDEMNIFICATION IN ADDITION TO THE PROVISIONS OF ARTICLE IX, THE CORPORATION MAY INDEMNIFY ITS VOLUNTEER DIRECTORS, VOLUNTEER OFFICERS, VOLUNTEERS, INDIVIDUALS, OR PERSONS IN THE FOLLOWING MANNER: 1. INDIVIDUALS. THE CORPORATION SHALL INDEMNIFY EVERY DIRECTOR, OFFICER AND VOLUNTEER OF THE ASSOCIATION AGAINST ALL EXPENSES AND LIABILITIES, INCLUDING REASONABLE ATTORNEY FEES AND AMOUNTS PAID IN SETTLEMENT INCURRED BY OR IMPOSED UPON THE DIRECTOR, OFFICER OR VOLUNTEER IN CONNECTION WITH ANY THREATENED, PENDING OR COMPLETED ACTION, SUIT OR PROCEEDING, WHETHER CIVIL, CRIMINAL, ADMINISTRATIVE, OR INVESTIGATIVE AND WHETHER FORMAL OR INFORMAL, TO WHICH THE DIRECTOR, OFFICER OR VOLUNTEER MAY BE A PARTY OR IN WHICH THEY MAY BECOME BY REASON OF THEIR BEING OR HAVING BEEN A DIRECTOR, OFFICER OR VOLUNTEER OF THE CORPORATION, WHETHER OR NOT THEY ARE A DIRECTOR, OFFICER OR VOLUNTEER AT THE TIME SUCH EXPENSES ARE INCURRED, IF THE PERSON ACTED IN GOOD FAITH AND IN A MANNER WHICH THEY REASONABLY BELIEVED TO BE IN OR NOT OPPOSED TO THE BEST INTERESTS OF THE CORPORATION AND, WITH RESPECT TO ANY CRIMINAL ACTION OR PROCEEDING, HAD REASONABLE CAUSE TO BELIEVE THAT THEIR CONDUCT WAS LAWFUL; PROVIDED, HOWEVER, THAT NO INDEMNIFICATION SHALL BE MADE IN RESPECT TO ANY CLAIM, ISSUE, OR MATTER AS TO WHICH SUCH PERSON SHALL HAVE BEEN FINALLY ADJUDGED TO BE LIABLE FOR GROSS NEGLIGENCE OR MISCONDUCT IN THE PERFORMANCE OF HIS DUTY TO THE CORPORATION UNLESS AND ONLY TO THE EXTENT THAT A COURT SHALL DETERMINE UPON APPLICATION THAT, DESPITE THE ADJUDICATION OF LIABILITY BUT IN VIEW OF ALL THE CIRCUMSTANCES OF THE CASE, SUCH PERSON IS FAIRLY AND REASONABLY ENTITLED TO INDEMNIFICATION FOR SUCH EXPENSES AS THE COURT SHALL DEEM PROPER. 2. EXPENSES. TO THE EXTENT THAT A DIRECTOR, OFFICER, OR VOLUNTEER HAS BEEN SUCCESSFUL ON THE MERITS OR OTHERWISE IN DEFENSE OF ANY ACTION, SUIT, OR PROCEEDING REFERRED TO IN SECTION 1, OR IN DEFENSE OF ANY CLAIM, ISSUE, OR MATTER THEREIN, AND INDEMNIFICATION IS GRANTED, THEY SHALL BE INDEMNIFIED AGAINST EXPENSES (INCLUDING ATTORNEYS' FEES) ACTUALLY AND REASONABLY INCURRED BY HIM IN CONNECTION THEREWITH AND IN ANY ACTION, SUIT OR PROCEEDING BROUGHT TO ENFORCE THE INDEMNIFICATION PROVIDED FOR HEREIN. 3. DETERMINATION OF RIGHT TO INDEMNIFICATION. EXCEPT IN A SITUATION GOVERNED BY SECTION 2, ANY INDEMNIFICATION UNDER SECTION 1 (UNLESS ORDERED BY A COURT) SHALL BE MADE BY THE CORPORATION ONLY AS AUTHORIZED IN THE SPECIFIC CASE UPON DETERMINATION THAT INDEMNIFICATION OF THE DIRECTOR, OFFICER, OR VOLUNTEER IS PROPER IN THE CIRCUMSTANCES BECAUSE THEY HAVE MET THE APPLICABLE STANDARD OF CONDUCT SET FORTH IN SECTION 1. SUCH DETERMINATION SHALL BE MADE (A) BY A MAJORITY VOTE OF DIRECTORS ACTING AT A MEETING AT WHICH A QUORUM CONSISTING OF DIRECTORS WHO WERE NOT PARTIES TO SUCH ACTION, SUIT, OR PROCEEDING IS PRESENT, OR (B) IF SUCH A QUORUM IS NOT OBTAINABLE (OR EVEN IF OBTAINABLE), AND A MAJORITY OF DISINTERESTED DIRECTORS SO DIRECTS, BY INDEPENDENT LEGAL COUNSEL (COMPENSATED BY THE CORPORATION), IN A WRITTEN OPINION, OR (C) IF SUCH A QUORUM IS NOT OBTAINABLE, THEN BY A MAJORITY VOTE OF A COMMITTEE OF DIRECTORS WHO ARE NOT PARTIES TO THE ACTION (SUCH COMMITTEE SHALL CONSIST OF NOT LESS THAN TWO (2) DISINTERESTED DIRECTORS), OR (D) BY THE SHAREHOLDERS OR MEMBERS. 4. ADVANCE PAYMENT OF EXPENSES. EXPENSES OF EACH PERSON INDEMNIFIED HEREUNDER INCURRED IN DEFENDING A CIVIL, CRIMINAL, ADMINISTRATIVE, OR INVESTIGATIVE ACTION, SUIT, OR PROCEEDING (INCLUDING ALL APPEALS), OR THREAT THEREOF, MAY BE PAID BY THE CORPORATION IN ADVANCE OF THE FINAL DISPOSITION OF SUCH ACTION, SUIT, OR PROCEEDING AS AUTHORIZED BY THE BOARD OF DIRECTORS, WHETHER A DISINTERESTED QUORUM EXISTS OR NOT, UPON RECEIPT OF AN UNDERTAKING BY OR ON BEHALF OF THE DIRECTOR, OFFICER, OR VOLUNTEER TO REPAY SUCH AMOUNT UNLESS IT SHALL ULTIMATELY BE DETERMINED THAT HE IS ENTITLED TO BE INDEMNIFIED BY THE CORPORATION. THE UNDERTAKING SHALL BE BY UNLIMITED GENERAL OBLIGATION OF THE PERSON ON WHOSE BEHALF ADVANCES ARE MADE, BUT NEED NOT BE SECURED. 5. RIGHTS NOT EXCLUSIVE. THE INDEMNIFICATION OR ADVANCEMENT OF EXPENSES PROVIDED BY THIS ARTICLE SHALL NOT BE DEEMED EXCLUSIVE OF ANY OTHER RIGHTS TO WHICH THOSE SEEKING INDEMNIFICATION OR ADVANCEMENT OF EXPENSES MAY BE ENTITLED AS A MATTER OF LAW OR UNDER THE ARTICLES OF INCORPORATION, THESE BYLAWS, OR ANY CONTRACTUAL AGREEMENT. HOWEVER, THE TOTAL AMOUNT OF EXPENSES FOR INDEMNIFICATION FROM ALL SOURCES COMBINED SHALL NOT EXCEED THE AMOUNT OF ACTUAL EXPENSES INCURRED BY THE PERSON SEEKING INDEMNIFICATION OR ADVANCEMENT OF EXPENSES. THE INDEMNIFICATION PROVIDED FOR IN THIS ARTICLE SHALL CONTINUE AS

TO A PERSON WHO HAS CEASED TO BE A DIRECTOR, OFFICER, OR VOLUNTEER AND SHALL INURE TO THE BENEFIT OF THE HEIRS, EXECUTORS, AND ADMINISTRATORS OF SUCH A PERSON. 6. DIRECTORS AND OFFICERS LIABILITY INSURANCE. THE CORPORATION MAY PURCHASE AND MAINTAIN INSURANCE ON BEHALF OF ANY PERSON WHO IS OR WAS A DIRECTOR, OFFICER, OR VOLUNTEER OF THE CORPORATION, OR IS OR WAS SERVING AT THE REQUEST OF THE CORPORATION AS A UNPAID, VOLUNTEER DIRECTOR, OFFICER, OR VOLUNTEER OF ANOTHER CORPORATION (WHETHER NONPROFIT OR FOR PROFIT), PARTNERSHIP, JOINT VENTURE, TRUST, OR OTHER ENTERPRISE AGAINST ANY LIABILITY ASSERTED AGAINST HIM AND INCURRED BY HIM IN ANY SUCH CAPACITY OR ARISING OUT OF HIS STATUS AS SUCH, WHETHER OR NOT THE CORPORATION WOULD HAVE THE POWER TO INDEMNIFY HIM AGAINST SUCH LIABILITY UNDER THE PROVISIONS OF THIS ARTICLE OR OF THE MICHIGAN NONPROFIT CORPORATION ACT. TO THE EXTENT THAT ANY PROVISION OF THIS ARTICLE X CONFLICTS WITH THE PROVISIONS OF ARTICLE IX, THE PROVISIONS OF ARTICLE IX SHALL BE CONTROLLING. ARTICLE XI ACTION WITHOUT MEETING ANY ACTION THAT MAY BE TAKEN AT A CORPORATION MEETING (EXCEPT FOR VOTING ON QUESTIONS OR PROPOSALS WHERE THE FULL QUESTION, PROPOSAL OR CHOICE IS NOT YET KNOWN) MAY BE TAKEN WITHOUT A MEETING BY WRITTEN VOTE OR BALLOT OF THE MEMBERS OR DIRECTORS, AS THE CASE MAY BE. WRITTEN VOTES OR BALLOTS SHALL BE SOLICITED IN THE SAME MANNER AS PROVIDED IN THESE BYLAWS FOR THE GIVING OF NOTICE OF CORPORATION MEETINGS. SUCH SOLICITATIONS SHALL SPECIFY: (A) THE PROPOSED ACTION; (B) THAT THE MEMBER HAS THE OPPORTUNITY TO VOTE FOR OR AGAINST ANY SUCH PROPOSED ACTION; (C) THE NUMBER OF RESPONSES NEEDED TO MEET THE QUORUM REQUIREMENTS; (D) THE PERCENTAGE OF APPROVALS NECESSARY TO APPROVE THE ACTION; AND (E) THE TIME BY WHICH WRITTEN VOTES MUST BE RECEIVED IN ORDER TO BE COUNTED. THE FORM OF WRITTEN VOTE OR BALLOT SHALL AFFORD AN OPPORTUNITY TO SPECIFY A CHOICE BETWEEN APPROVAL AND DISAPPROVAL OF EACH MATTER AND SHALL PROVIDE THAT, WHERE THE MEMBER SPECIFIES A CHOICE, THE VOTE SHALL BE CAST IN ACCORDANCE WITH THE MEMBER'S SPECIFICATION. APPROVAL BY WRITTEN VOTE OR BALLOT SHALL BE CONSTITUTED BY RECEIPT, WITHIN THE TIME PERIOD SPECIFIED IN THE SOLICITATION, OF: (I) A NUMBER OF WRITTEN VOTES OR BALLOTS WHICH EQUALS OR EXCEEDS THE QUORUM THAT WOULD BE REQUIRED IF THE ACTION WERE TAKEN AT A MEETING; AND (II) A NUMBER OF APPROVALS THAT EQUALS OR EXCEEDS THE NUMBER OF VOTES THAT WOULD BE REQUIRED FOR APPROVAL IF THE ACTION WERE TAKEN AT A MEETING. ARTICLE XII REMOVAL OF DIRECTORS AT ANY ANNUAL OR SPECIAL MEETING OF THE CORPORATION DULY CALLED AND HELD, ANY ONE OR MORE OF THE DIRECTORS MAY BE REMOVED WITH OR WITHOUT CAUSE BY THE AFFIRMATIVE VOTE OF MORE THAN 50% OF ALL MEMBERS AND A SUCCESSOR MAY THEN AND THERE BE ELECTED TO FILL ANY VACANCY CREATED. THE QUORUM REQUIRED TO ELECT ANY SUCCESSOR OF A REMOVED DIRECTOR SHALL BE THE NORMAL QUORUM REQUIREMENT SET FORTH IN THE BYLAWS. ANY DIRECTOR WHOSE REMOVAL HAD BEEN PROPOSED SHALL BE GIVEN AN OPPORTUNITY TO BE HEARD AT THE MEETING.

2. The foregoing amendment to the Articles of Incorporation proposed by the board was duly adopted on: 08/14/2017 by the

Member or shareholder approval for nonprofit corporations organized on a membership or share basis shareholders at a meeting in accordance with Section 611(3) of the Act.

Directors (Only if the Articles state that the corporation is organized on a directorship basis)

This document must be signed by an authorized officer or agent:

Signed this 7th Day of December, 2017 by:

Signature	Title	Title if "Other" was selected
Stephen Guerra	Authorized Agent	

By selecting ACCEPT, I hereby acknowledge that this electronic document is being signed in accordance with the Act. I further certify that to the best of my knowledge the information provided is true, accurate, and in compliance with the Act.

Decline Accept

MICHIGAN DEPARTMENT OF LICENSING AND REGULATORY AFFAIRS

FILING ENDORSEMENT

This is to Certify that the CERTIFICATE OF AMENDMENT TO THE ARTICLES OF
INCORPORATION

for

MORAVIAN MEADOWS ASSOCIATION

ID Number: 800800187

received by electronic transmission on December 07, 2017 ***, is hereby endorsed.***

Filed on December 07, 2017, ***by the Administrator.***

The document is effective on the date filed, unless a subsequent effective date within 90 days after received date is stated in the document.



In testimony whereof, I have hereunto set my hand and affixed the Seal of the Department, in the City of Lansing, this 7th day of December, 2017.

Julia Dale, Director
Corporations, Securities & Commercial Licensing Bureau